
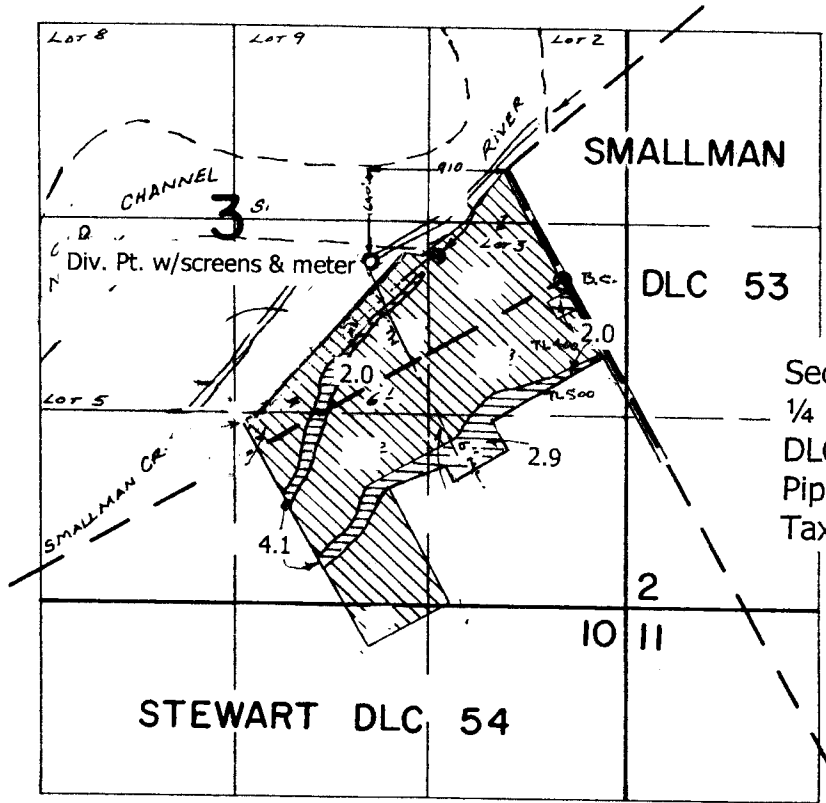


FINAL PROOF SURVEY MAP  
MT. JEFFERSON FARMS, INC.  
Section 3, T 10 S R 2 W, W.M.  
Scale 4" = 1 mile

T-10117 (cert. 36903)


RECEIVED  
PLAT 10117  
NOV 19 1987  
COUNTY OF CLATSOP

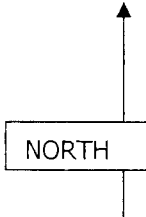

- Section line \_\_\_\_\_
- 1/4 1/4 line \_\_\_\_\_
- DLC line \_\_\_\_\_
- Pipe line \_\_\_\_\_
- Tax Lot line \_\_\_\_\_

Div. Pt.: 640' S & 910' W from the NW corner DLC 53

This map is not intended to provide dimensions  
or locations of property ownership lines.

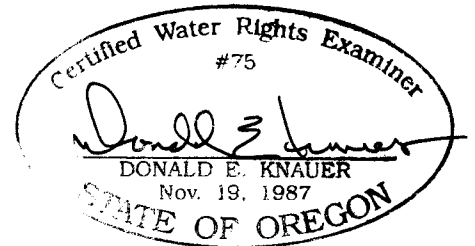

RENEWAL DATE: 6/30/2015