

FINAL PROOF MAP IN THE NAME OF MT. JEFFERSON FARMS, INC., Walter R. Miller T 10 S R 2 W, W.M.




1/4

T-10117 (cert. 46586)

RECEIVED

NOV 19 1967

PLANNING DIVISION
LAND DIVISION

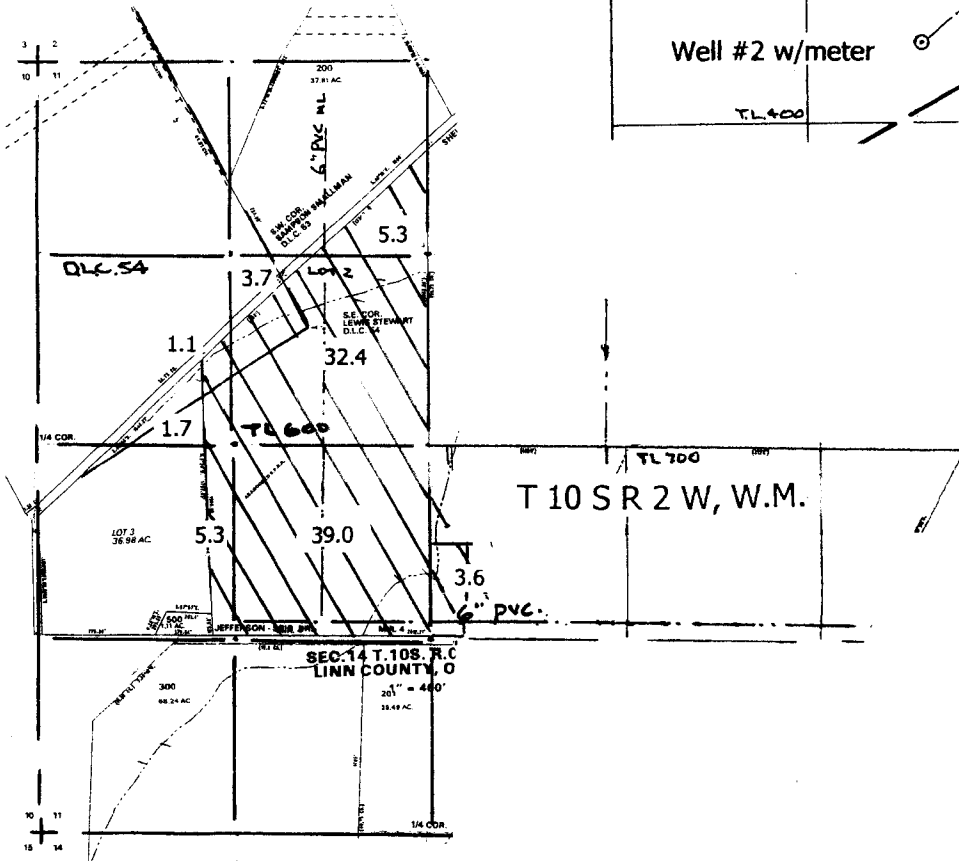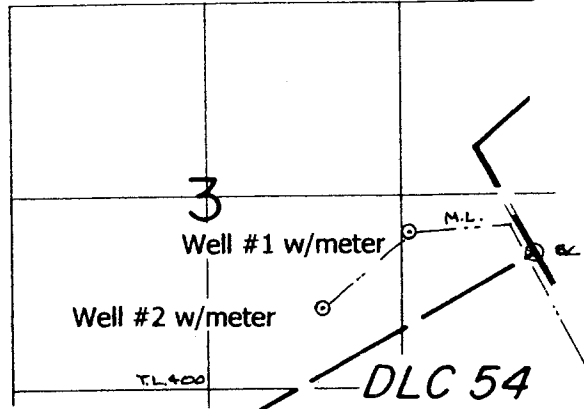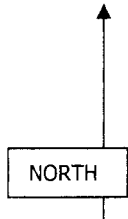

- Section line _____
- 1/4 1/4 line _____
- DLC line _____
- Pipe line _____
- Tax Lot line _____

Well 1: 140' N & 860' W from the NE corner DLC 54
Well 2: 350' S & 1450' W from the NE corner DLC 54

Scale 1" = 1320'

This map is not intended to provide legal dimensions or locations of property ownership lines.

