



2/4

FINAL PROOF SURVEY MAP
 MT. JEFFERSON FARMS, INC.
 Section 3, T 10 S R 2 W, W.M.
 Scale 4" = 1 mile

T-10117 (cert. 57856)

RECEIVED


NOV 19 1987
 STATE OF OREGON
 DEPT. OF LAND AND WATER

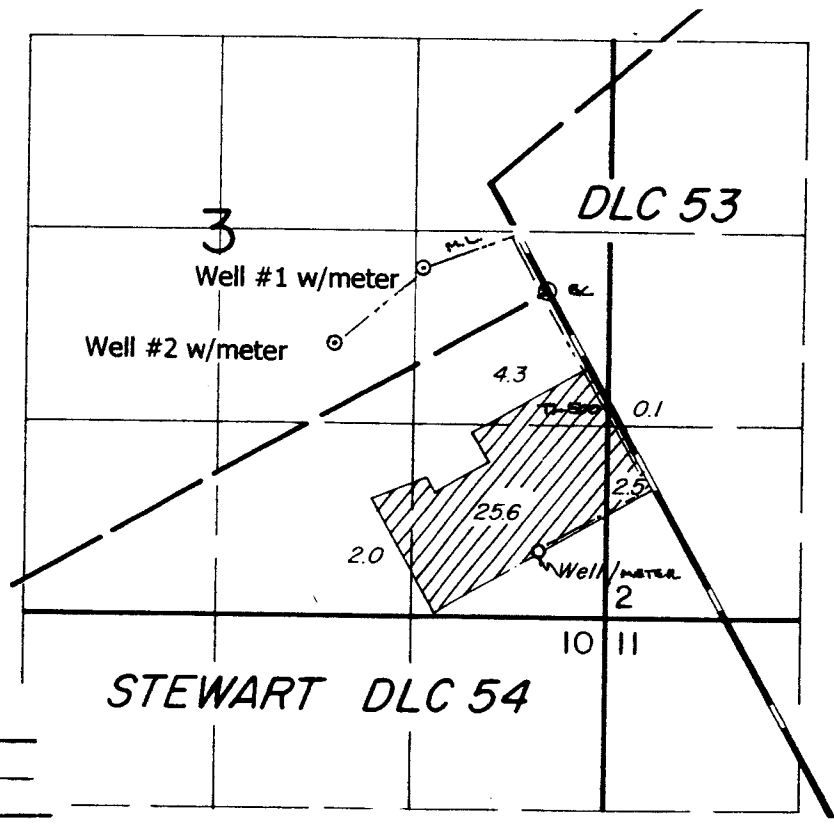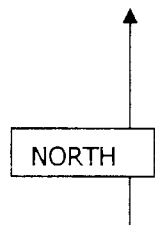

- Section line _____
- 1/4 1/4 line _____
- DLC line _____
- Pipe line _____
- Tax Lot line _____

WELL #1: 140' N & 860' W from the NE corner DLC 54
 WELL #2: 350' S & 1450' W from the NE corner DLC 54
 Original POA: 450' N & 450' W from the SE corner sec.3

This map is not intended to provide legal dimensions or locations of property ownership lines.

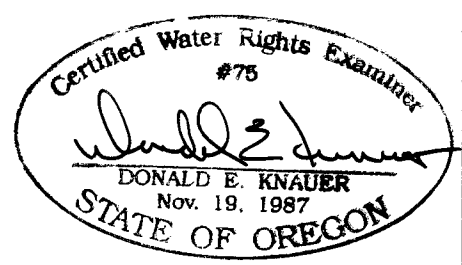

RENEWAL DATE: 6-30-2015