

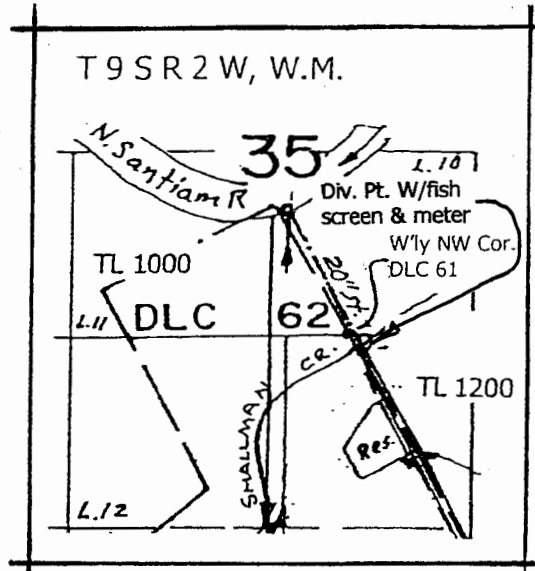


FINAL PROOF SURVEY MAP IN THE NAME OF MT. JEFFERSON FARMS, INC., Walter R. Miller T 10 S R 2 W, W.M.

4/4

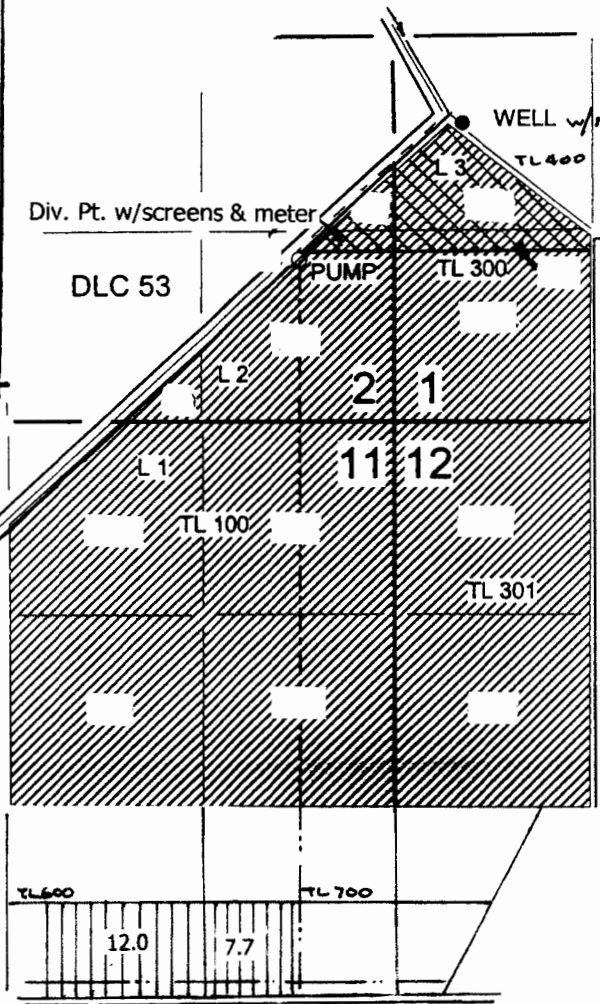

T-10117 (cert. 57883, 57884 & permit G-15178)

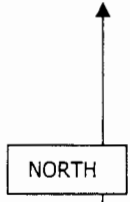


RECEIVED
NOV 19 1987
STATE OF OREGON

- Section line _____
- 1/4 1/4 line _____
- DLC line _____
- Pipe line _____
- Tax Lot line _____

Smallman Cr. Div. Pt.: 50' S & 100' E from the Westerly NW corner DLC 61 T9S R2W
Sucker Slough Div. Pt.: 1120' N & 650' W from the SE corner Sec. 2 T10S R2W

WELL: 80' S & 160' E from the SE corner DLC 53

Scale 1" = 1320'

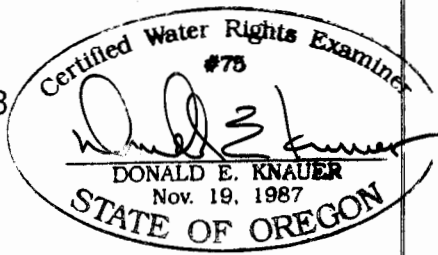

This map is not intended to provide legal dimensions or locations of property ownership lines.

RENEWAL DATE: 6-30-2015