



CLAIM OF BENEFICIAL USE  
 FOR JAN AND PAMELA KROGNESS  
 BY DUANE W. KIRBY  
 T26S, R6W WM, SEC 23  
 APPLICATION NO S-86313  
 PERMIT NO S-54354  
 SCALE 1" = 400'

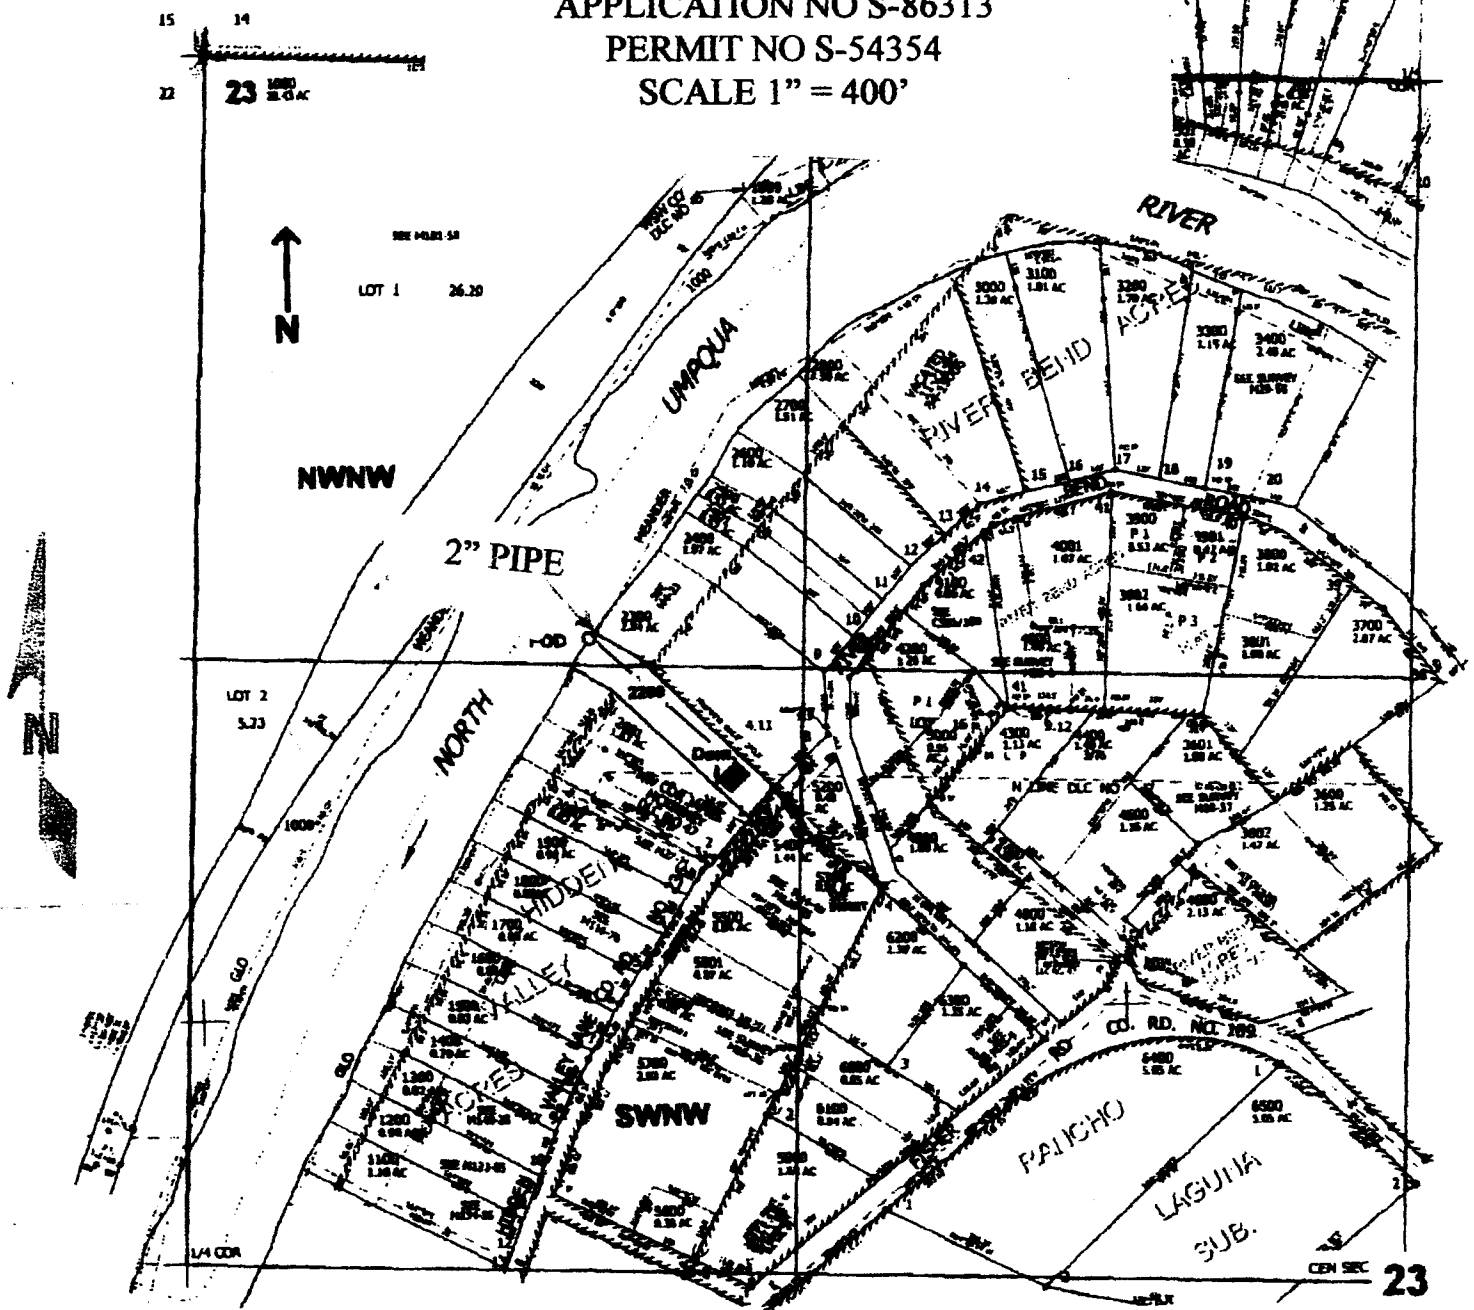

POD is located 1250 ft. S. and 850 ft. E. from the NW corner of Sec. 23

THE PURPOSE OF THIS MAP IS TO IDENTIFY THE LOCATION OF THE WATER RIGHT. IT IS NOT INTENDED TO PROVIDE INFORMATION RELATIVE TO THE LOCATION OF PROPERTY OWNERSHIP BOUNDARY LINES.

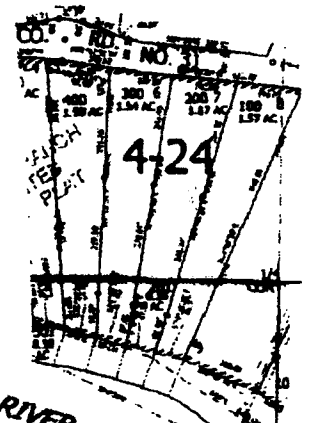