


CLAIM OF BENEFICIAL USE

APPLICATION R-84719
APPLICATION S-84718

PERMIT R-13233
PERMIT S-53786


IN THE NAME OF PATRICK LANE

SECTION 4, TOWNSHIP 30 SOUTH, RANGE 9 WEST, W.M.
DOUGLAS COUNTY OREGON

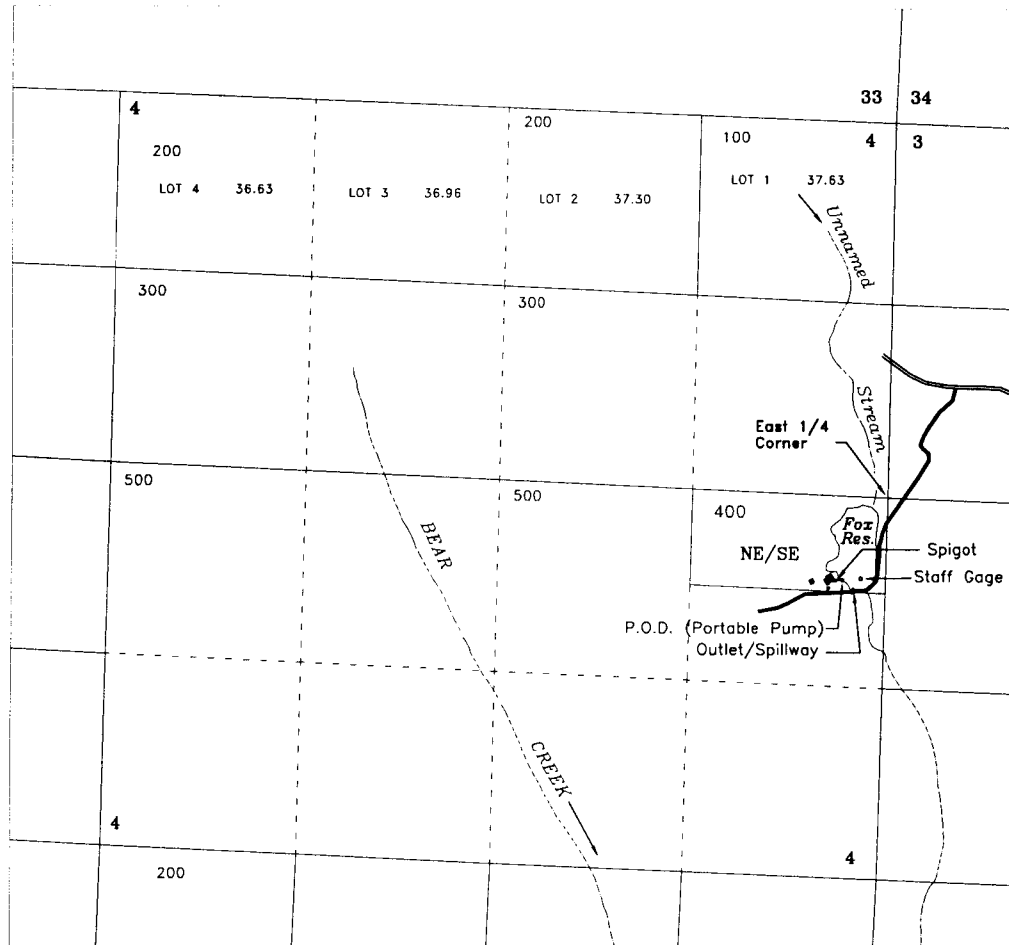

Point of Diversion (P.O.D.) - NE/SE, 580 Feet South & 290 Feet West
from the East 1/4 Corner Section 4

Outlet/Spillway - NE/SE, 640 Feet South & 215 Feet West
from the East 1/4 Corner Section 4

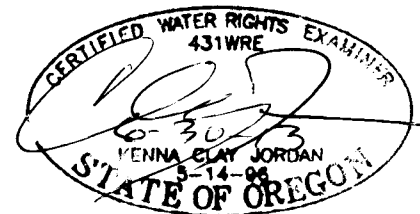

Fox Reservoir - 13 Acre-Feet

Permit R-13233 - Use of Water - Storage for: Domestic Use Expanded
Wetland, Wildlife, Aquatic Life, Recreation & Fire Protection


Buildings

Permit S-53786 - Domestic Use, Expanded

Base map from Douglas County
GIS over 2005 FSA aerial photo
for assumed best fit

Mapped from field
inspection September 8, 2010

Scale
1 inch = 1320 feet

 

This map is not intended to provide legal dimensions
or locations of property ownership lines

JORDAN ENGINEERING
460 JORDAN LANE
ROSEBURG, OR 97471
(541) 673-1931

1/04/2011