


CLAIM OF BENEFICIAL USE

APPLICATION R-84719
APPLICATION S-84718

PERMIT R-13233
PERMIT S-53786


IN THE NAME OF PATRICK LANE

SECTION 4, TOWNSHIP 30 SOUTH, RANGE 9 WEST, W.M.
DOUGLAS COUNTY OREGON

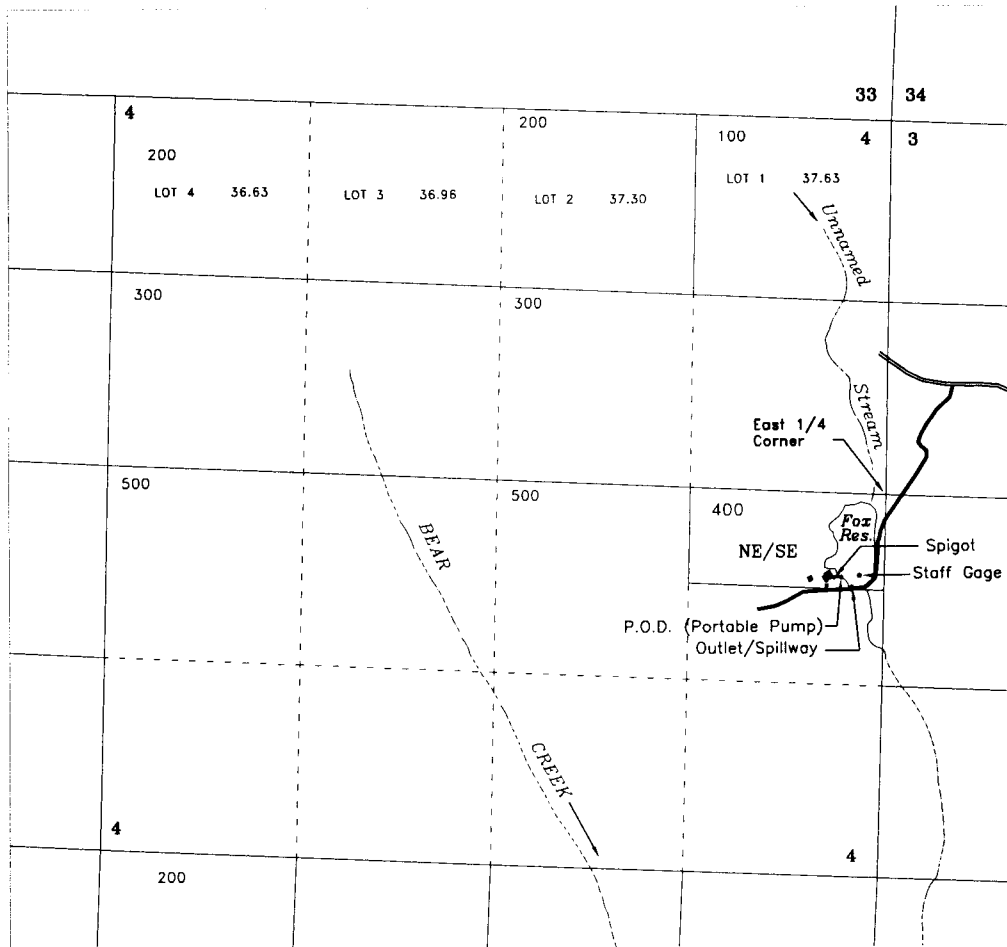

Point of Diversion (P.O.D.) - NE/SE, 580 Feet South & 290 Feet West
from the East 1/4 Corner Section 4

Outlet/Spillway - NE/SE, 640 Feet South & 215 Feet West
from the East 1/4 Corner Section 4

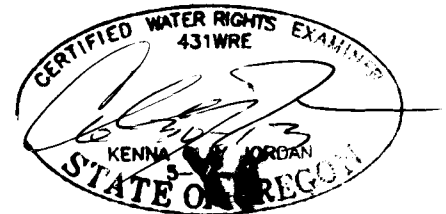

Fox Reservoir - 13 Acre-Feet

Permit R-13233 - Use of Water - Storage for: Domestic Use Expanded
Wetland, Wildlife, Aquatic Life, Recreation & Fire Protection

Buildings

Permit S-53786 - Domestic Use, Expanded

Scale

1 inch = 1320 feet



Base map from Douglas County
GIS over 2005 FSA aerial photo
for assumed best fit

Mapped from field
inspection September 8, 2010

JORDAN ENGINEERING
460 JORDAN LANE
ROSEBURG, OR 97471
(541) 673-1931

1/04/2011

This map is not intended to provide legal dimensions
or locations of property ownership lines