

CLAIM OF BENEFICIAL USE MAP



SEC 35 T16S R2E WM

TAX LOT 1607

APPLICATION # S-72494, PERMIT # S-51989

SCALE: 1" = 400'

POINT OF DIVERSION
1460 FT NORTH AND
200' WEST OF THE S 1/4
CORNER, SEC 35

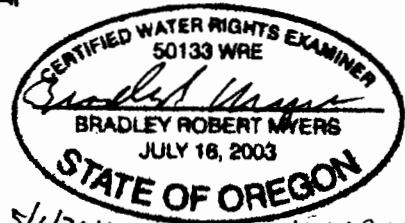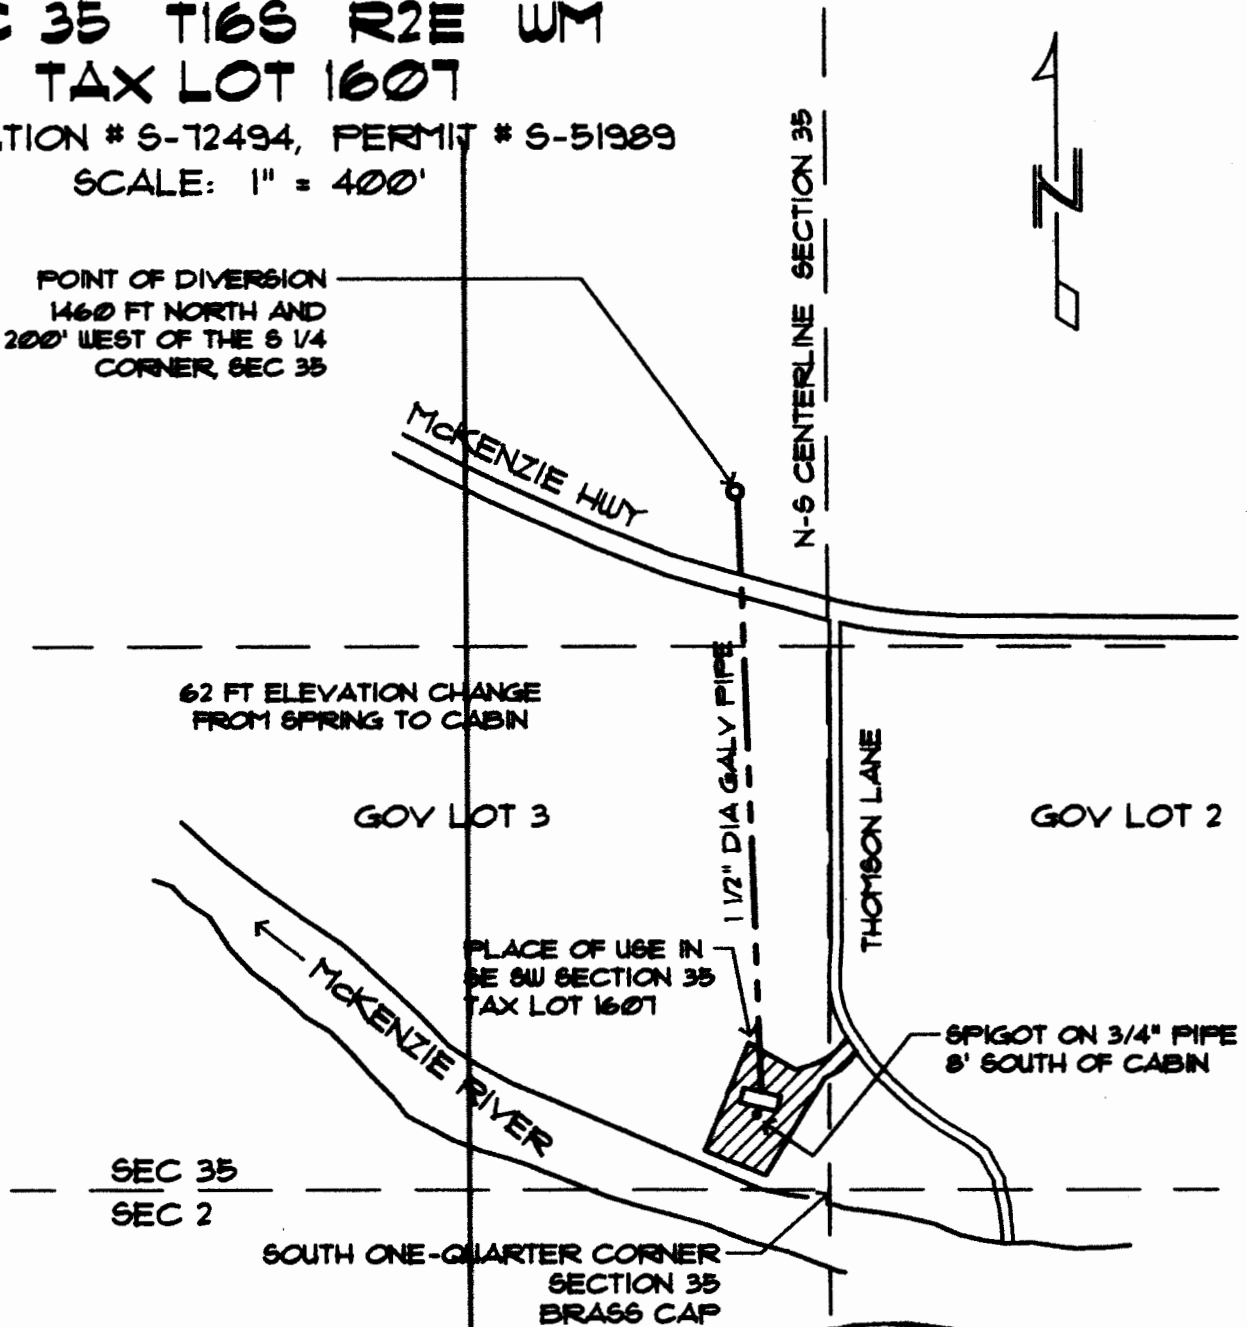

5/6/2011 W0:19685

RENEWAL DATE: DEC. 31, 2012

MORTIER ENGINEERING, P.E., P.C.
144 E 14th AVE.
EUGENE, OR 97401
PHONE: 541-484-9080
eng@mortiereng.com

THE PURPOSE OF THIS MAP IS TO IDENTIFY THE LOCATION OF THE WATER RIGHT. THIS MAP IS NOT INTENDED TO PROVIDE LEGAL DIMENSIONS OR LOCATIONS OF PROPERTY OWNERSHIP LINES.