


T. 37S., R. 2E., W. M.

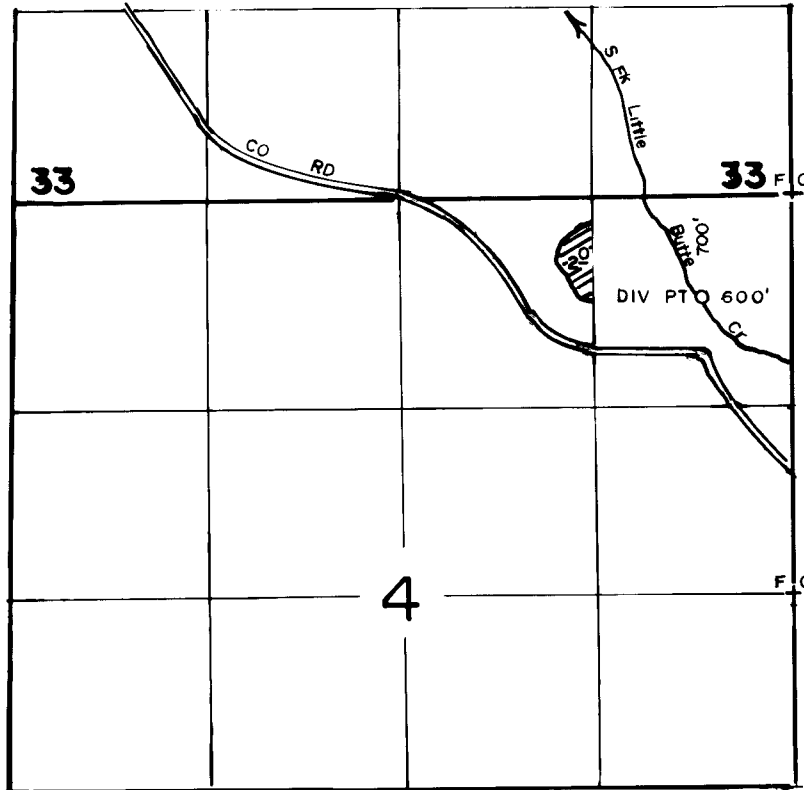

SCALE: 1" = 1320'

FINAL PROOF SURVEY

UNDER

TRANSFER NO. 4807

Application No. Permit No.
IN NAME OF

..... **JOHN R. WEST**

Surveyed JULY 13, 1989, by B.S. JAMES