


P-8033

9211

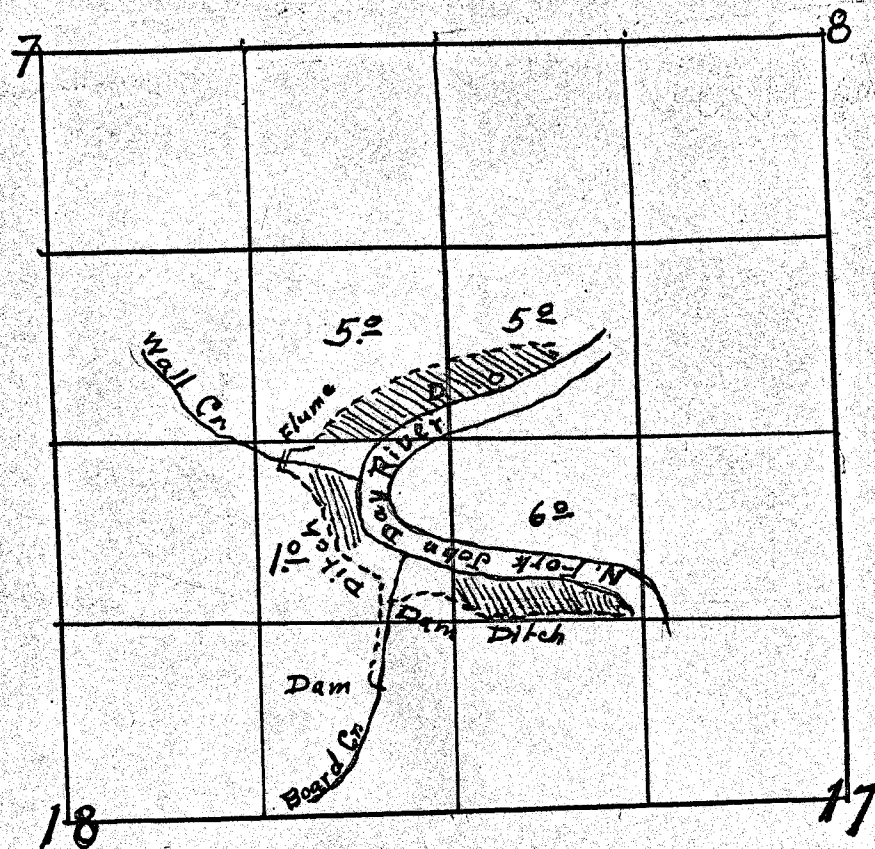

SE 1/4 Sec. 7, SW 1/4 Sec. 8, NW 1/4 Sec. 17, NE 1/4 Sec. 18. T. 8 S. R. 28 E

To accompany application of E.C. Schafer.

Application No. 11594 11594
Permit No. 8033

11204