


T.9S. R.3W. Section 14, W.M.

JUL 07 2011


WATER RESOURCES DEPT
SALEM, OREGON

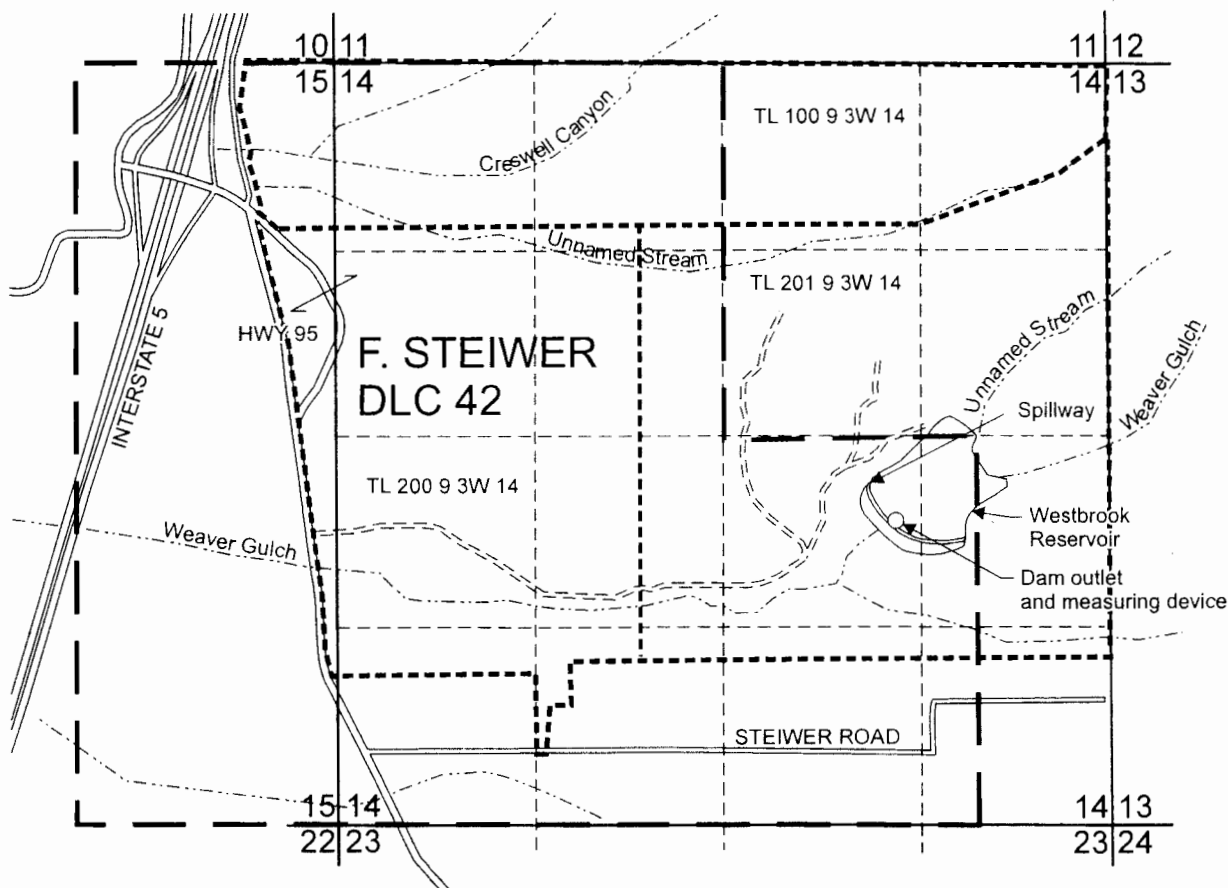

Dam outlet and measuring device - 2100 feet north and 1470 feet west of the southeast corner of Section 14

Westbrook Reservoir - 121.0 AF, Application R-84036, Permit R-12733, and 20.2 AF, Application R-84703, Permit R-13367

----- Tax lot boundary

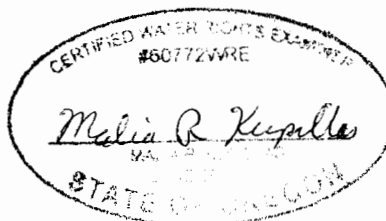

EXPIRATION DATE 6/30/2013

Scale: 1" = 1,320'



0 1,320 Feet

This map was prepared for the purpose of identifying the location of a water right only and is not intended to provide legal dimensions or location of property ownership lines.



Pacific Hydro-Geology Inc.

Claim of Beneficial Use Map
Application R-84036, Permit R-12733
Application R-84703, Permit R-13367

Krautmann Family Nursery LLC
Tax Lot 201 9 3W 14

6/2011 - bgp