


THIS MAP IS FOR THE PURPOSE OF IDENTIFYING THE LOCATION OF THE WATER RIGHT ONLY. THERE IS NO INTENT TO PROVIDE DIMENSIONS OR LOCATION OF PROPERTY OWNERSHIP LINES.

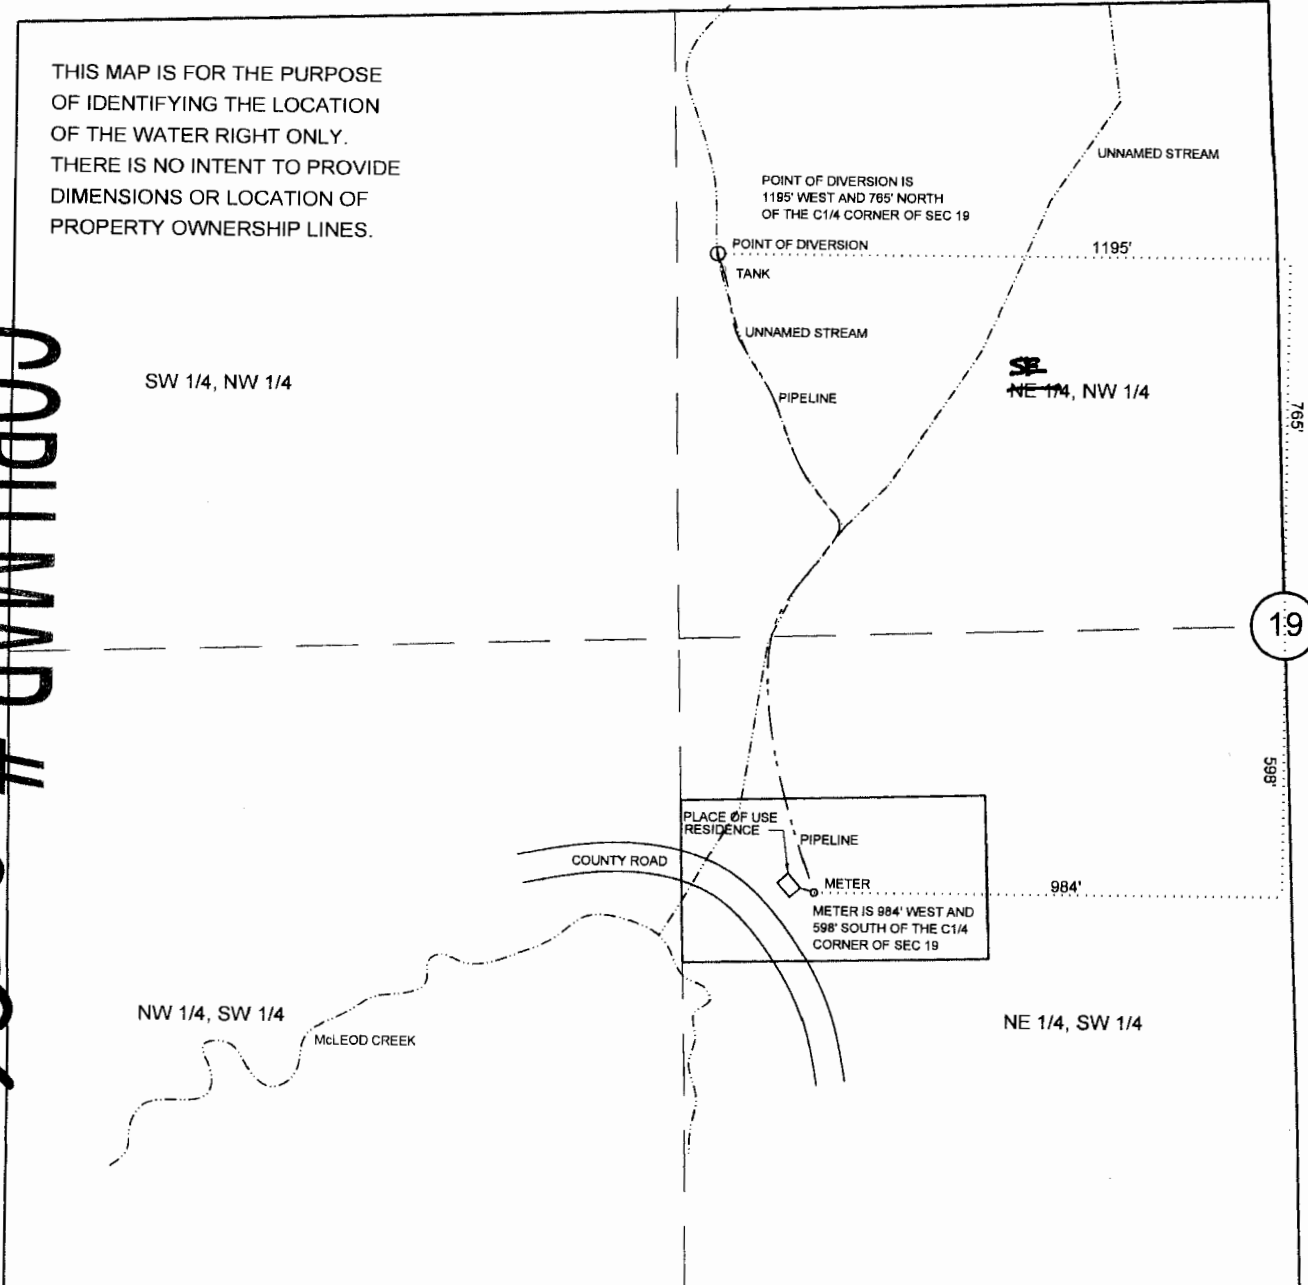

COBU MAP # 0596

John

FINAL PROOF SURVEY CLAIM OF BENEFICIAL USE WATER RIGHTS MAP

MID COAST BASIN
UNDER

PERMIT 54566
APPLICATION NO S-87309

NE 1/4, SW 1/4, SEC 19, T17S, R10W, W.M.
17-10-19, T.L. 200
LANE COUNTY, OREGON

FOR: TIMOTHY SWEET
09551 NORTH FORK ROAD
FLORENCE, OREGON 97439

PREPARED BY: WOBBE & ASSOCIATES, INC.
510 KINGWOOD ST. / P.O. BOX 3093
FLORENCE, OR 97439
DATE: APRIL 8, 2011



RECEIVED

