T.23S. R.6E. Section 14, W.M.

(Section and 16th Lines are Unsurveyed and Shown Only in Approximate Locations)

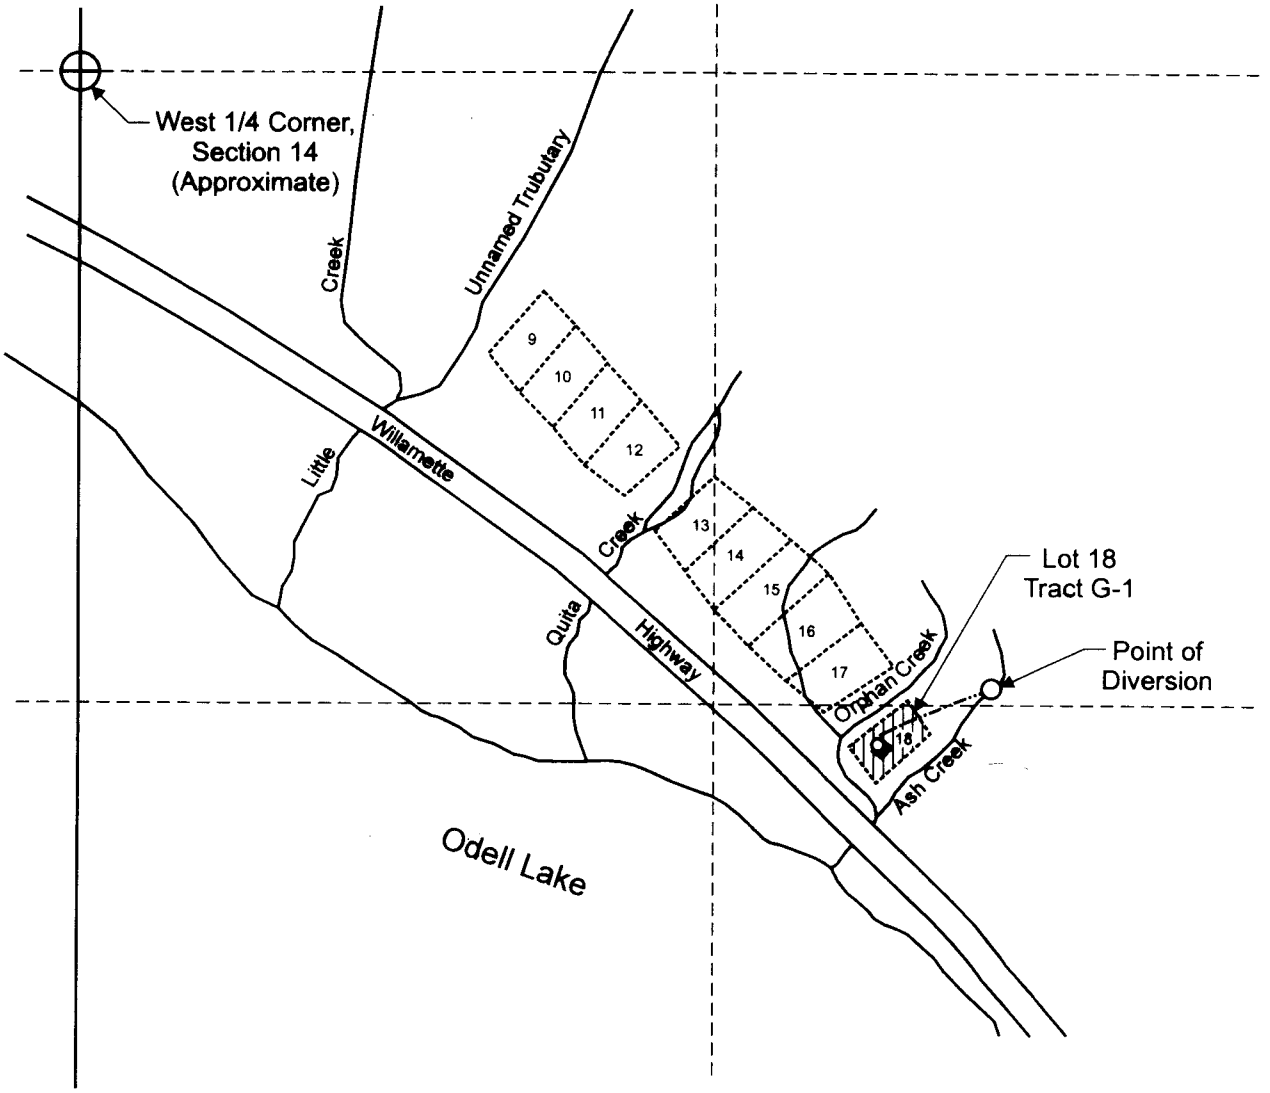

Point of diversion is located 20 feet north and 170 feet east from the most northerly corner, Lot 18, Tract G-1.

Area of use for Human Consumption

Tax lot boundary

Cabin Location

Meter Location

Mainline

Scale: 1" = 400'

0 400 800 Feet

Certified Water Rights Examiner
#432WRE
GREGORY E. KUPILLAS
MAY 14, 1996
STATE OF OREGON

EXPIRATION DATE: 6/30/2013

N

This map was prepared for the purpose of identifying the location of a water right only and is not intended to provide legal dimensions or location of property ownership lines.

Pacific Hydro-Geology Inc.

Claim of Beneficial Use Map
Application S-87319, Permit S-54628
Louis Blaser
T.23S. R.6E. Section 14, W.M., Tract G-1, Lot 18

08/2011

BlazerOdellSWCOBU.cdr