


T. 26 S., R. 15 E., W.M.

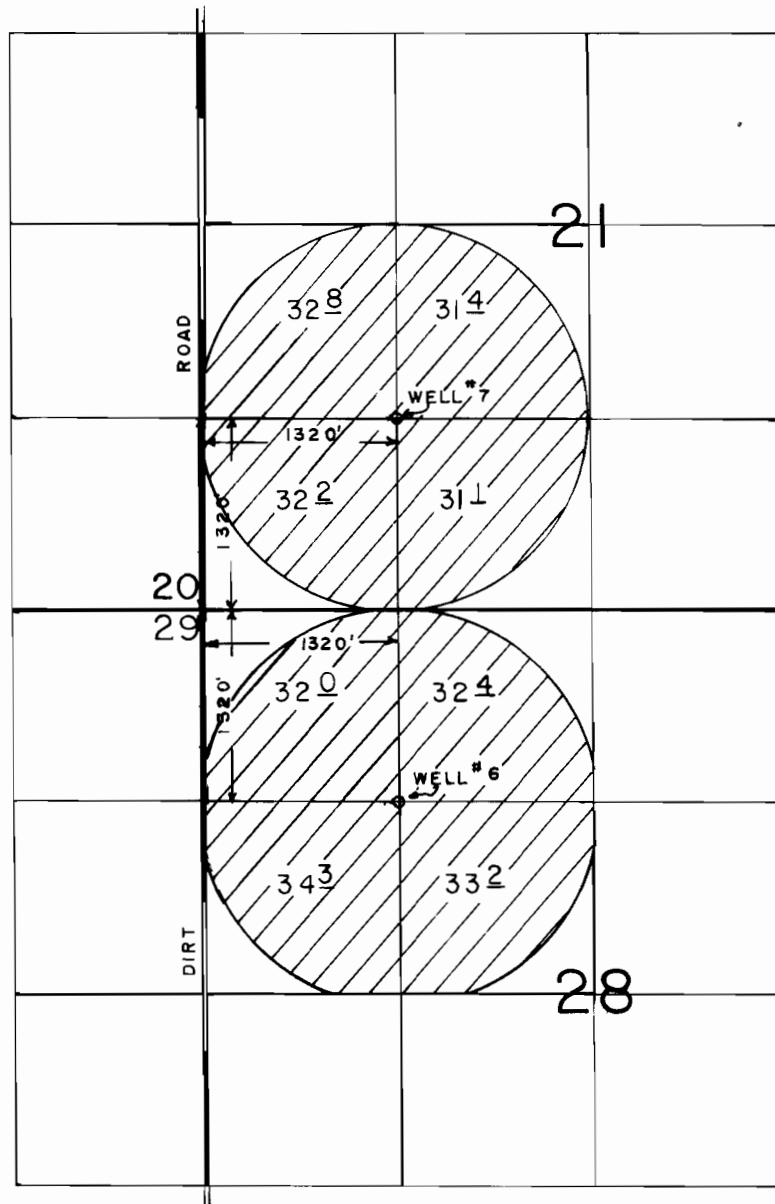

SCALE 1"=1320'

FINAL PROOF SURVEY
UNDER

Application No. G-11246 Permit No. G-10804
IN NAME OF


SAM DINSDALE

Surveyed APRIL 6, 1992, by B.W. BISHOP


TRANSFER MAP TO ACCOMPANY APPLICATION TO CHANGE PLACE OF USE & ADD A POINT OF APPROPRIATION FOR DINSDALE FARMS, INC.

"FROM" TAX LOT 4404
IN SECTION 28, TOWNSHIP 26 SOUTH, RANGE 15 EAST, W.M.
LAKE COUNTY, OREGON

"TO" TAX LOT 3500 IN SECTION 23,
TOWNSHIP 27 SOUTH, RANGE 15 EAST, W.M.
LAKE COUNTY, OREGON

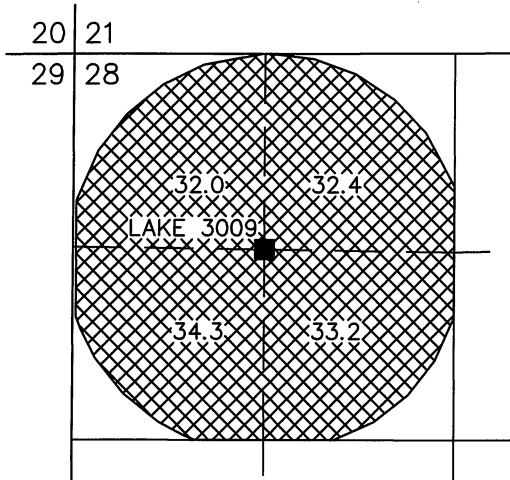


SCALE 4" = 1 MILE

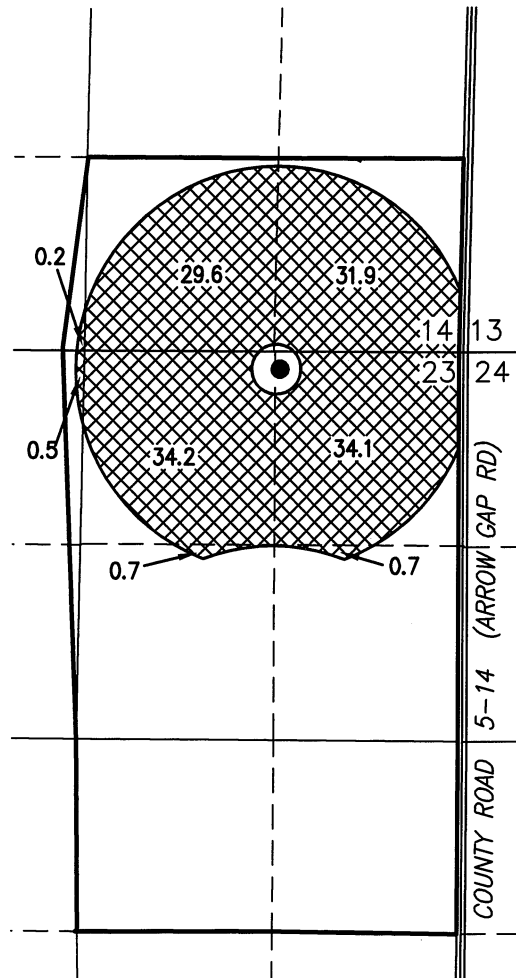

POA 5

LAKE 3009 (G11246) IN THE NW 1/4 NW 1/4
SECTION 28, T26S R15E, W.M. LOCATED 1320 FEET
SOUTH AND 1320 FEET EAST FROM THE NW
CORNER OF SECTION 28.

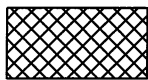


131.9 ACRES PRIMARY GROUND WATER
RIGHTS FROM CERTIFICATE #68269
(G-11246) TRANSFERRED AS SHOWN.

POA 6

LAKE 52379 PROPOSED WELL IN THE NE 1/4 NE
1/4 SECTION 23, T27S R15E, W.M. LOCATED 120
FEET SOUTH AND 1278 FEET WEST FROM THE NE
CORNER OF SECTION 23.

THIS MAP IS FOR THE PURPOSE OF LOCATING A WATER
RIGHT ONLY AND HAS NO INTENT TO PROVIDE LEGAL
DIMENSIONS OR THE LOCATION OF PROPERTY LINES.

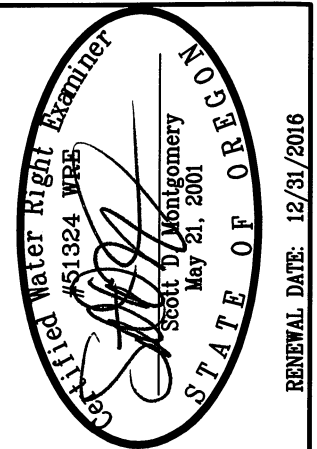

**ALL POINTS ENGINEERING
& SURVEYING, INC.**

P.O. BOX 767
TERREBONNE, OREGON 97760
(541) 548-5833 PH
Scott@APEandS.com
www.APEandS.com

PROJECT No. 16-052

PREPARED AT THE REQUEST OF:
DINSDALE FARMS, INC.
57673 COUNTY ROAD 5-10
SILVER LAKE, OR 97638