
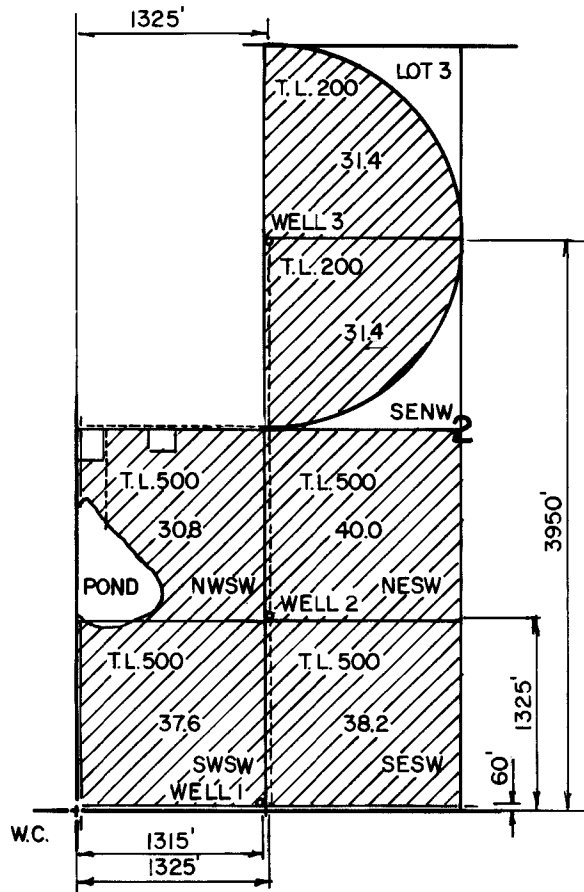


T 23 S, R 32 E, WM

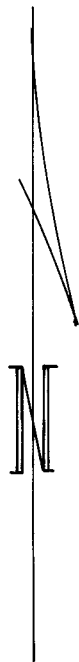


THE PURPOSE OF THIS MAP IS TO IDENTIFY THE LOCATION OF THE WATER RIGHT. IT IS NOT INTENDED TO PROVIDE INFORMATION RELATIVE TO THE LOCATION OF PROPERTY OWNERSHIP.

RECEIVED

APR 08 2002

WATER RESOURCES DEPT.
SALEM, OREGON

 RENEW 1-1-2003	FINAL PROOF SURVEY		IN THE NAME OF ERNIE RUHL	
	UNDER APPLICATION NO. G-13822 PERMIT NO. G-12676			
	Scale: 4" = 1 MILE	Date: APR. 2002	Job: 2068	
	Dsn:	 M.A. PALMER & SONS, INC. ENGINEERING & SURVEYING 711 Ponderosa Village • Box 61 Burns, Oregon 97720	Sht. No.	
	Drn: CHRIS		of 1	
Ckd:				

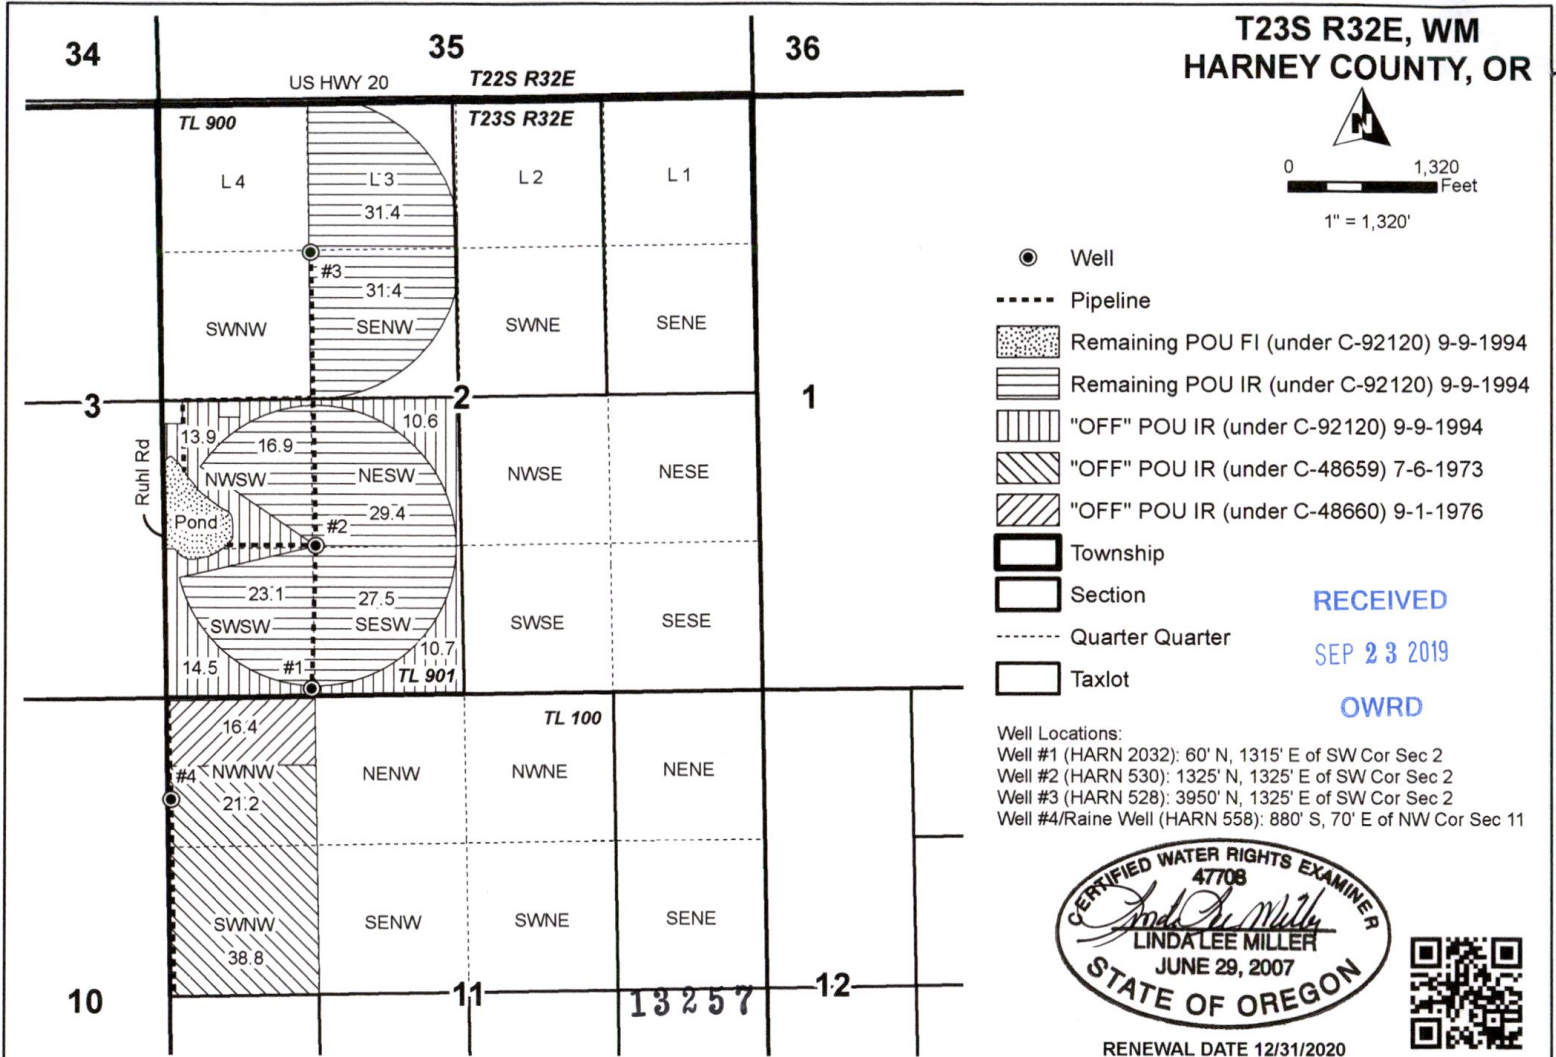

TRANSFER "OFF" MAP
Roger and Mindy Sheley


Transfer of Certificates 48659, 48660, & 92120

Date: 9/2/2019

This map is not intended
to provide legal dimensions
or locations of property
ownership lines.

WATER RIGHT SERVICES, LLC
PO BOX 1830, BEND, OR 97709
WWW.OREGONWATER.US CCB # 197121
johnshort@usa.com 541-389-2837


**T23S R32E, WM
HARNEY COUNTY, OR**

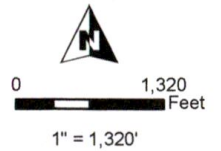

- Well
- Pipeline
- "ON" POU IR (under C-48659) 7-6-1973
- "ON" POU IR (under C-48660) 9-1-1976
- "ON" POU IR (under C-92120) 9-9-1994
- Section
- Quarter Quarter
- Taxlot

RECEIVED
SEP 23 2019
OWRD

Well Locations:
Well #1 (HARN 2032): 60' N, 1315' E of SW Cor Sec 2
Well #2 (HARN 530): 1325' N, 1325' E of SW Cor Sec 2
Well #4/Raine Well (HARN 558): 880' S, 70' E of NW Cor Sec 11
Well #5 (HARN 50898/L-53105): 1650' S, 110' E of W 1/4 Cor Sec 11

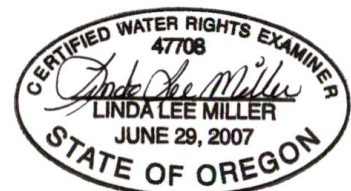

RENEWAL DATE 12/31/2020

**TRANSFER "ON" MAP
Roger and Mindy Sheley**

Transfer of Certificates 48659, 48660, & 92120

Date: 9/2/2019

This map is not intended
to provide legal dimensions
or locations of property
ownership lines.

WATER RIGHT SERVICES, LLC
PO BOX 1830, BEND, OR 97709
WWW.OREGONWATER.US CCB # 197121
johnshort@usa.com 541-389-2837

