


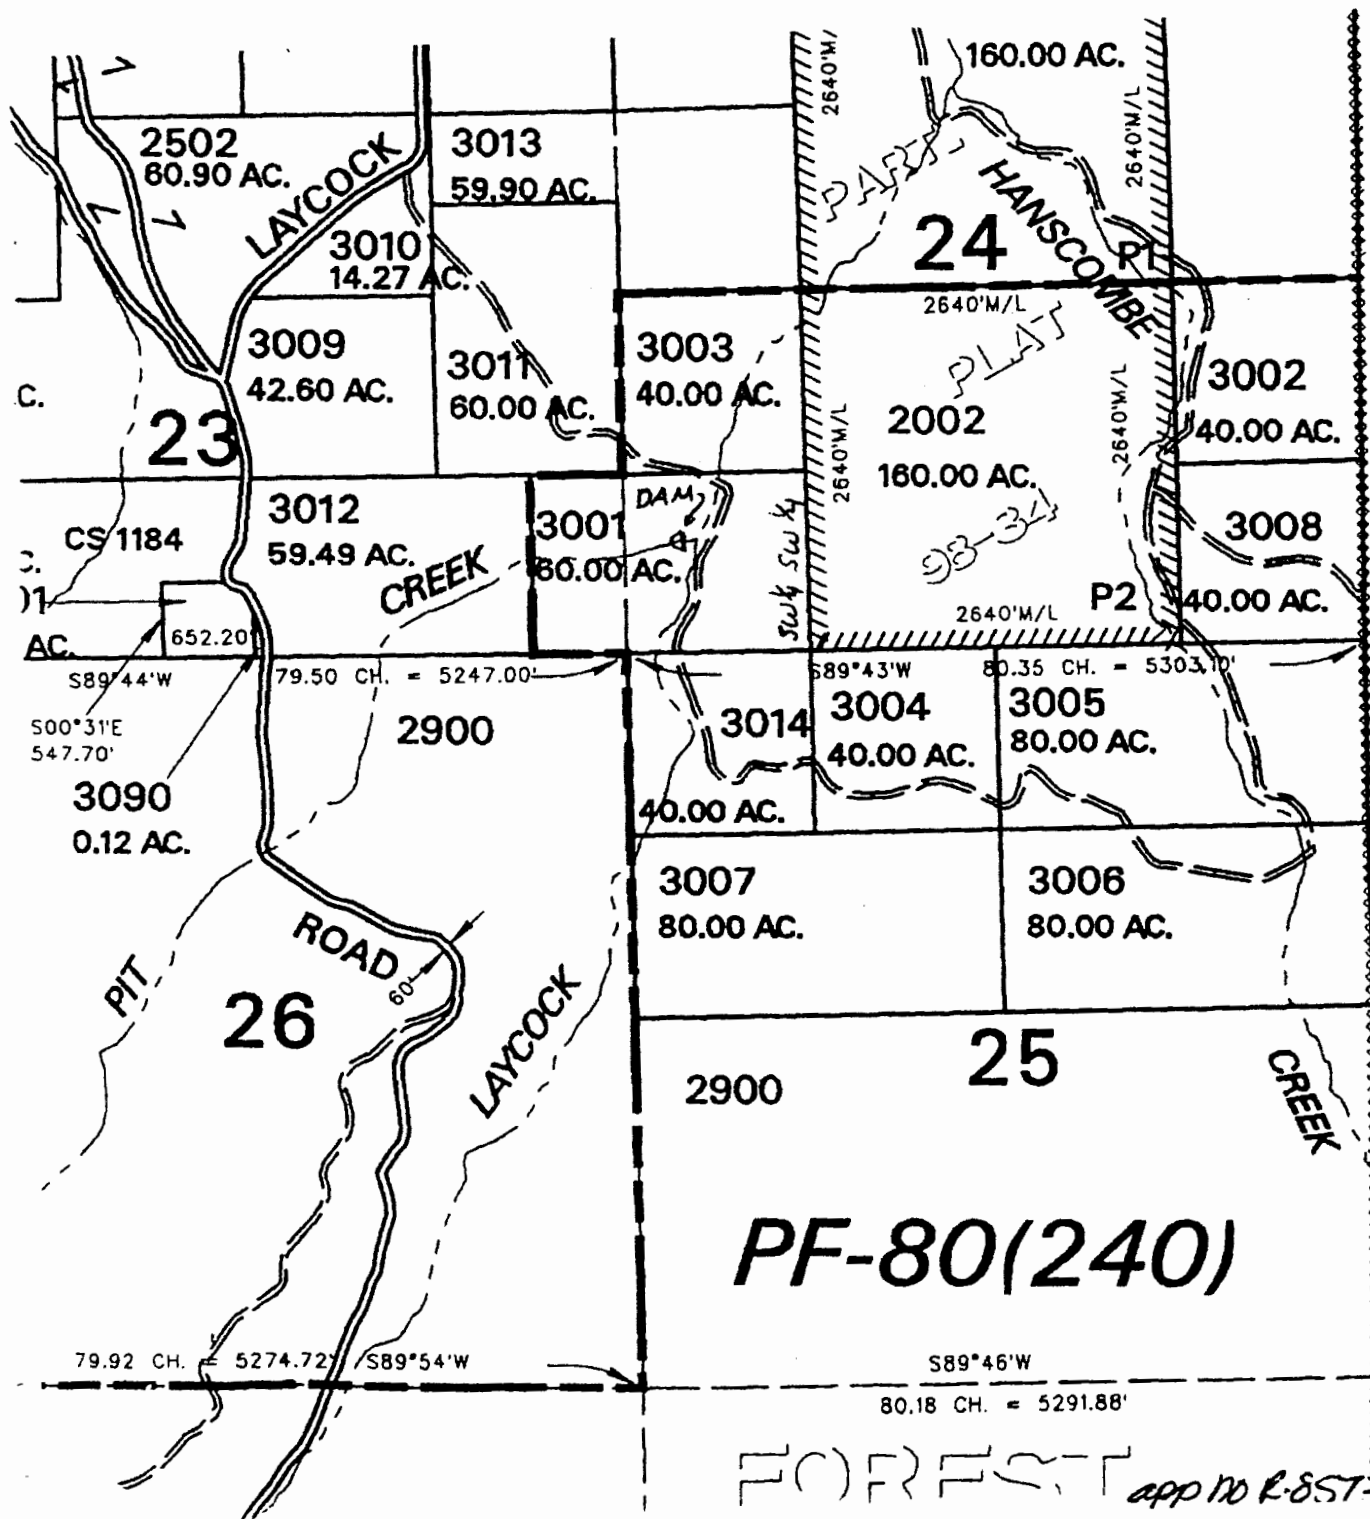


SEE MAP 1

RECEIVED

AUG 07 2003

WATER RESOURCES DEPT
SALEM, OREGON

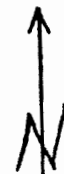

T. 14 S., R. 30 E., W. 4.

Scale 4" = 1 mile

Tax Lot 3001
Ref 173

Dam is Located About
820 feet North and
430 feet East from
the SW corner of
Section 24,
T 14 S., R. 30 E., W. 4.

RECEIVED BY OWRD

DEC 07 2015

SALEM, OR

Jinda L. McDonald
Signature

8/5/2003
DATE

FOREST app No R-85721 D. m. + n. D 12-00