


Acres 0.25 AC All acres listed are Net Acres, except portions of the taxlot within public right-of-way.

NOTES

Tick Marks: If a tick mark is indicated on the map, then the dimension goes to the tick mark. When dimensions extend into public right-of-way, the dimension goes to the centerline.

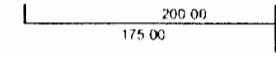

CANCELLED NUMBERS

RECEIVED

JAN 05 2016

WATER RESOURCES DEPT
SALEM, OREGON

DISCLAIMER: THIS MAP WAS PREPARED FOR ASSESSMENT PURPOSES ONLY.




Assessors Office
Cartography Department

FOR ADDITIONAL MAPS VISIT OUR WEBSITE
www.co.marion.or.us

PLOT DATE: 10/7/2015

05 3W 25

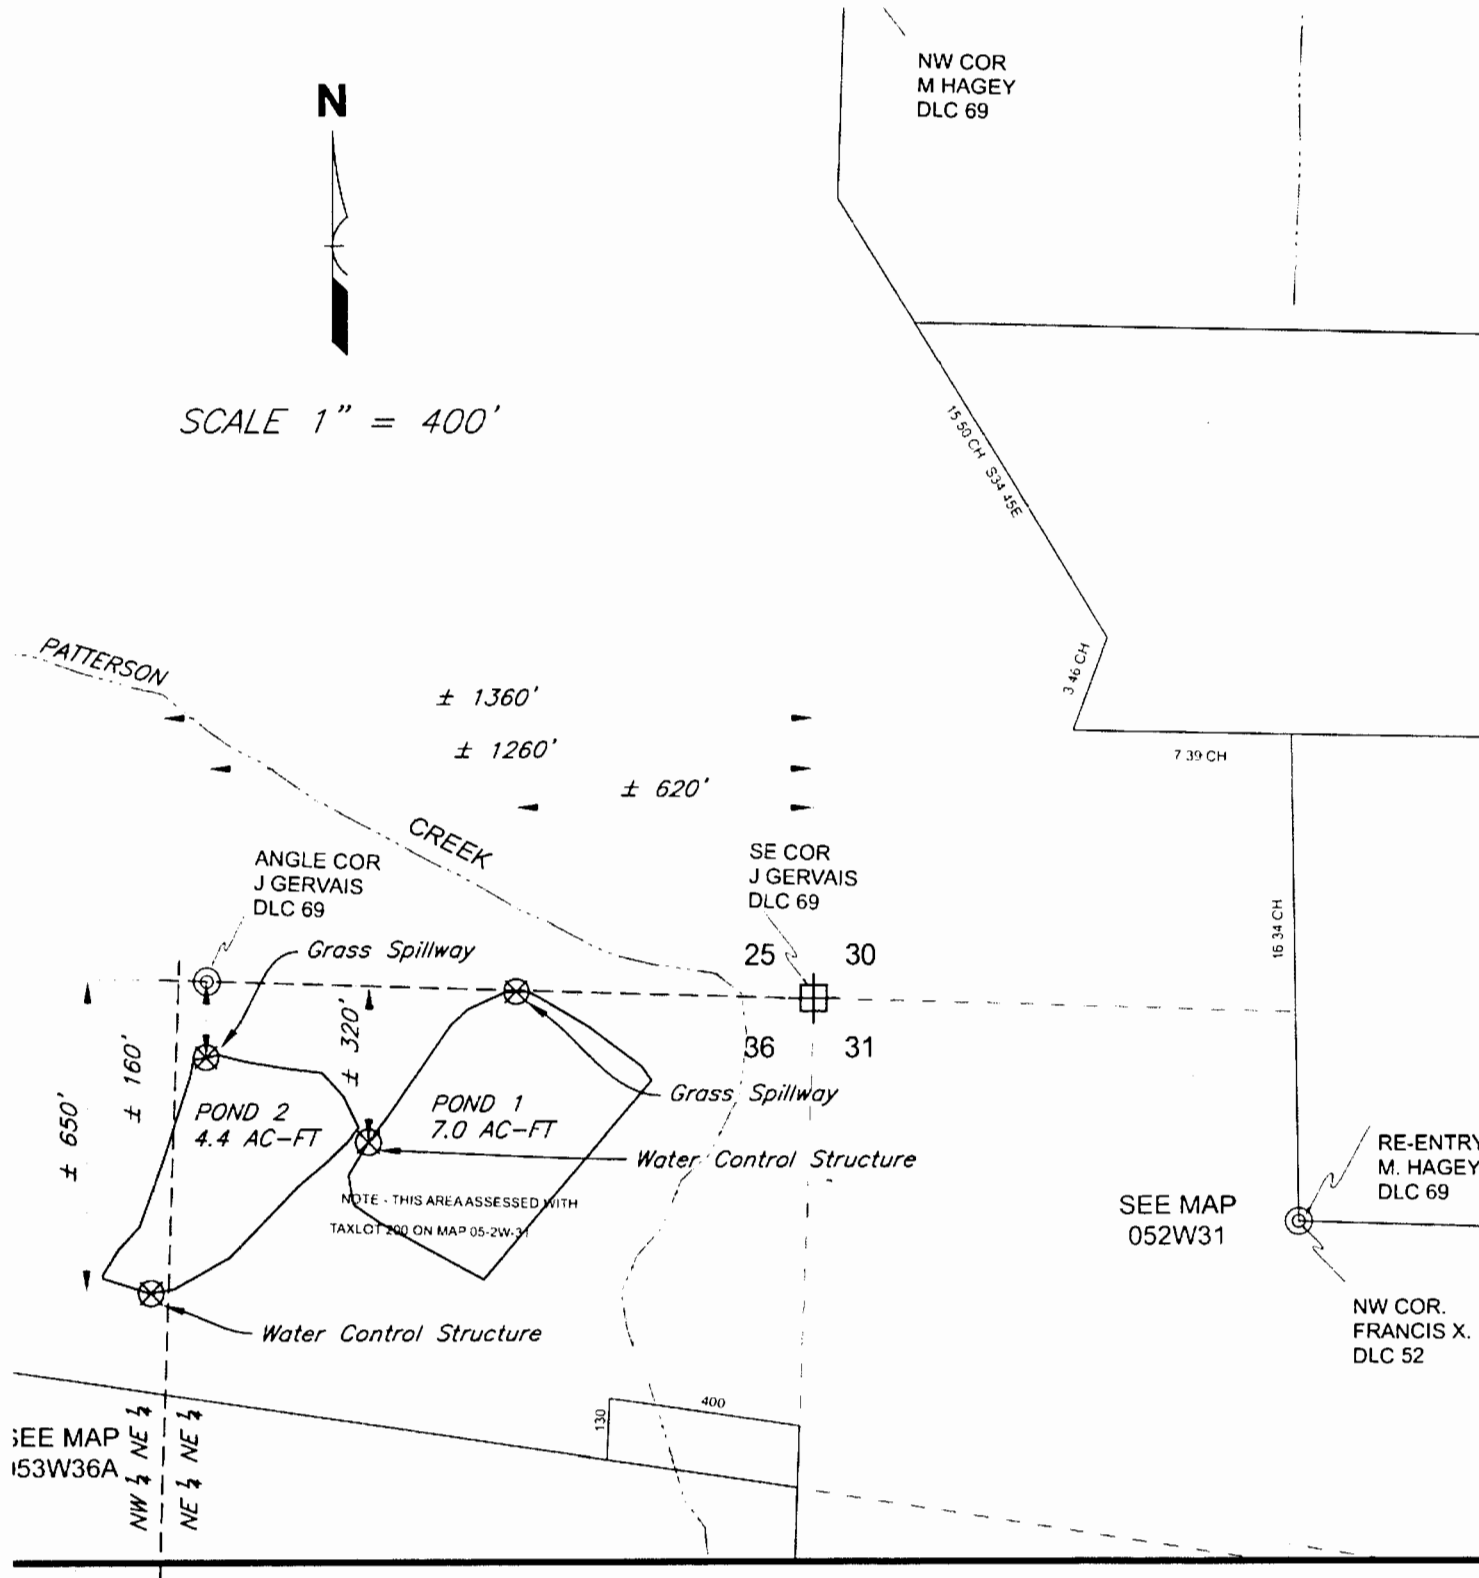

SEE MAP 153W36A
NW 1/4 NE 1/4
NE 1/4 NE 1/4

SEE MAP 052W31

RE-ENTRY
M. HAGEY
DLC 69

NW COR.
FRANCIS X. L.
DLC 52