


DEC 09 2015

LAYTON / SMITH-MOORE
WATER CLAIM
R-13440

SALEM, OR

LY 2 3/4"
1978

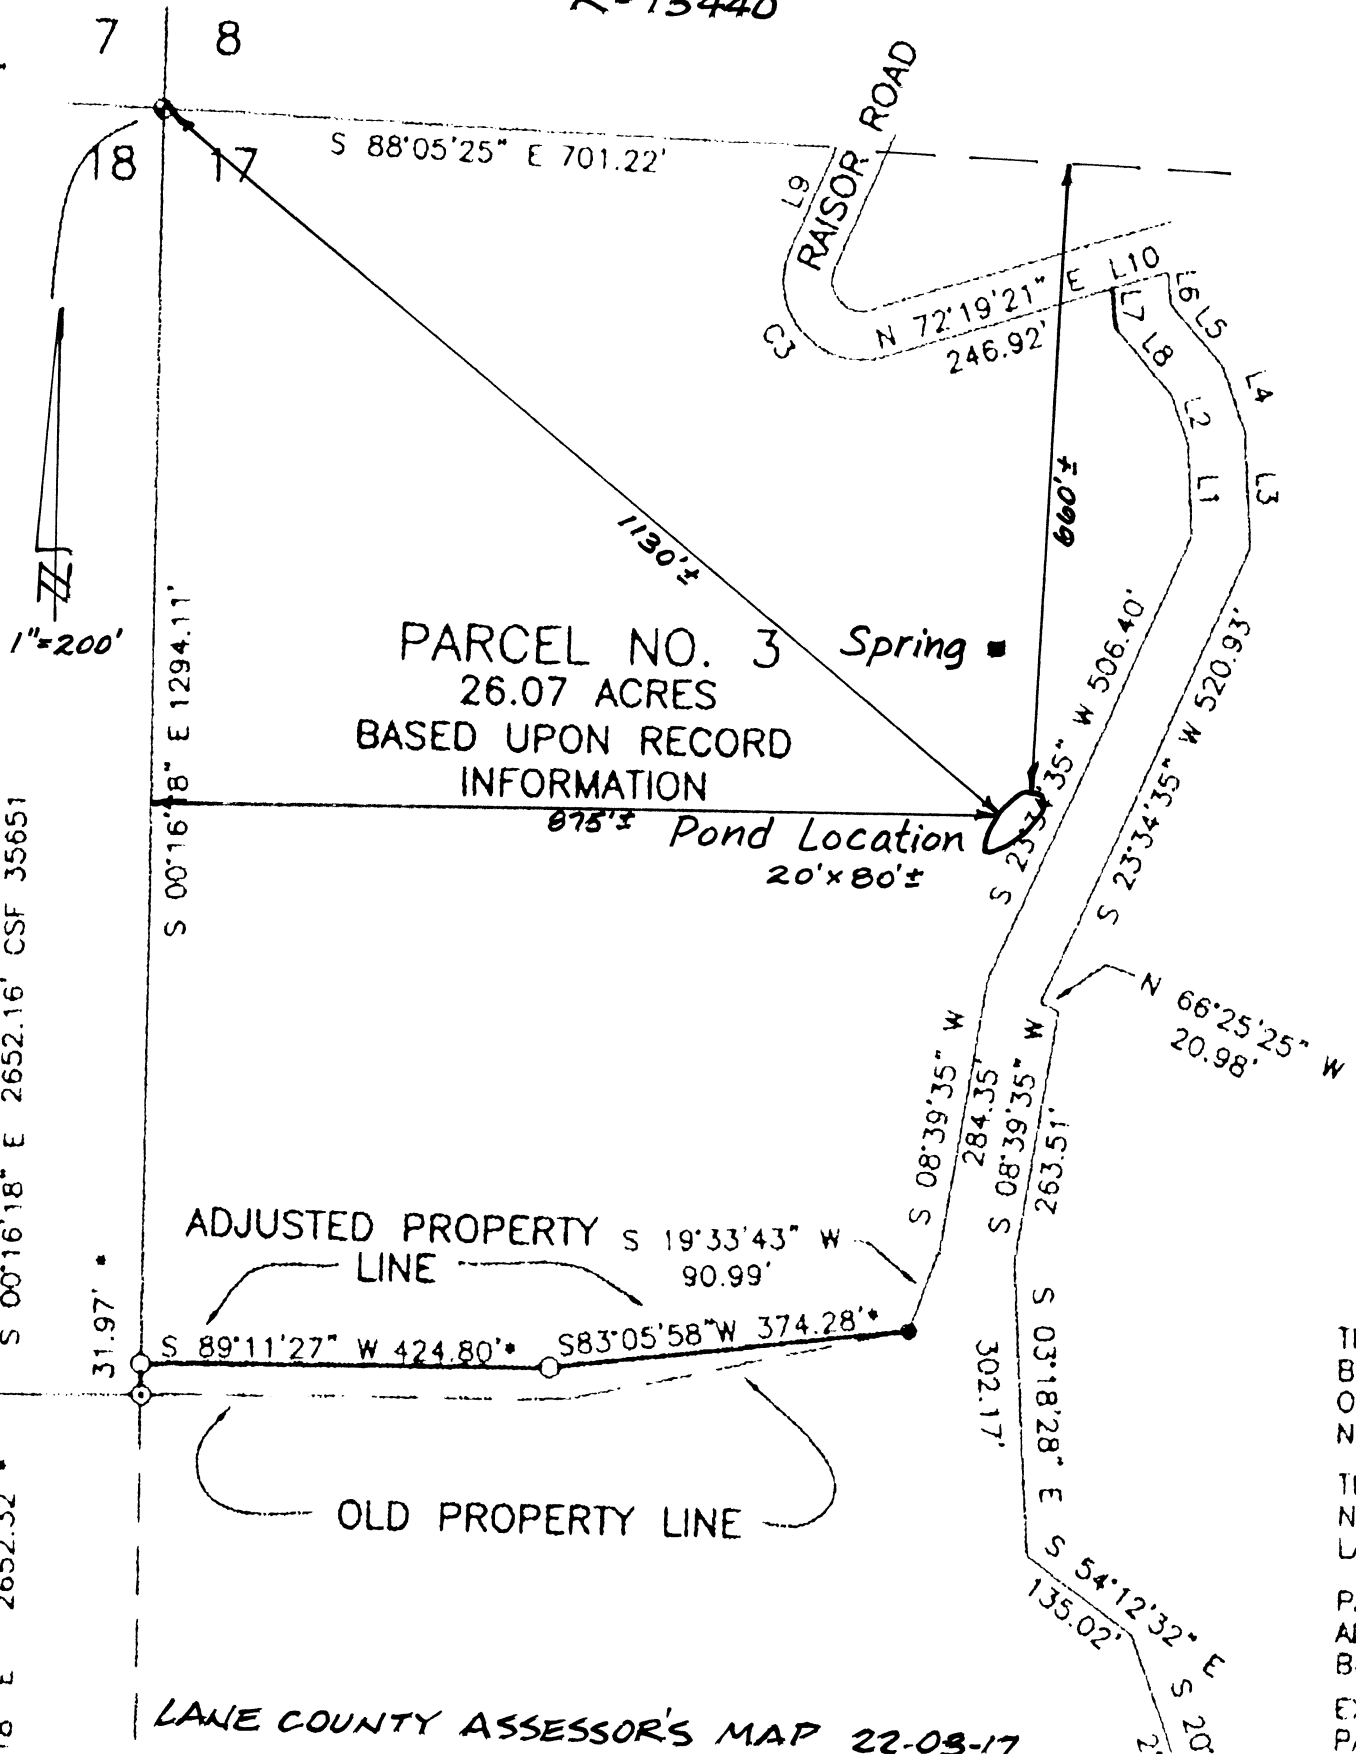

CL
C1
C2
C3

THE F
BETWE
OF TH
NO. 9
THIS
NOR I
LANE
PARCE
ADJUS
BETWE
EXCEP
PARCE