


TOWNSHIP 6 SOUTH, RANGE 3 WEST, W.M.

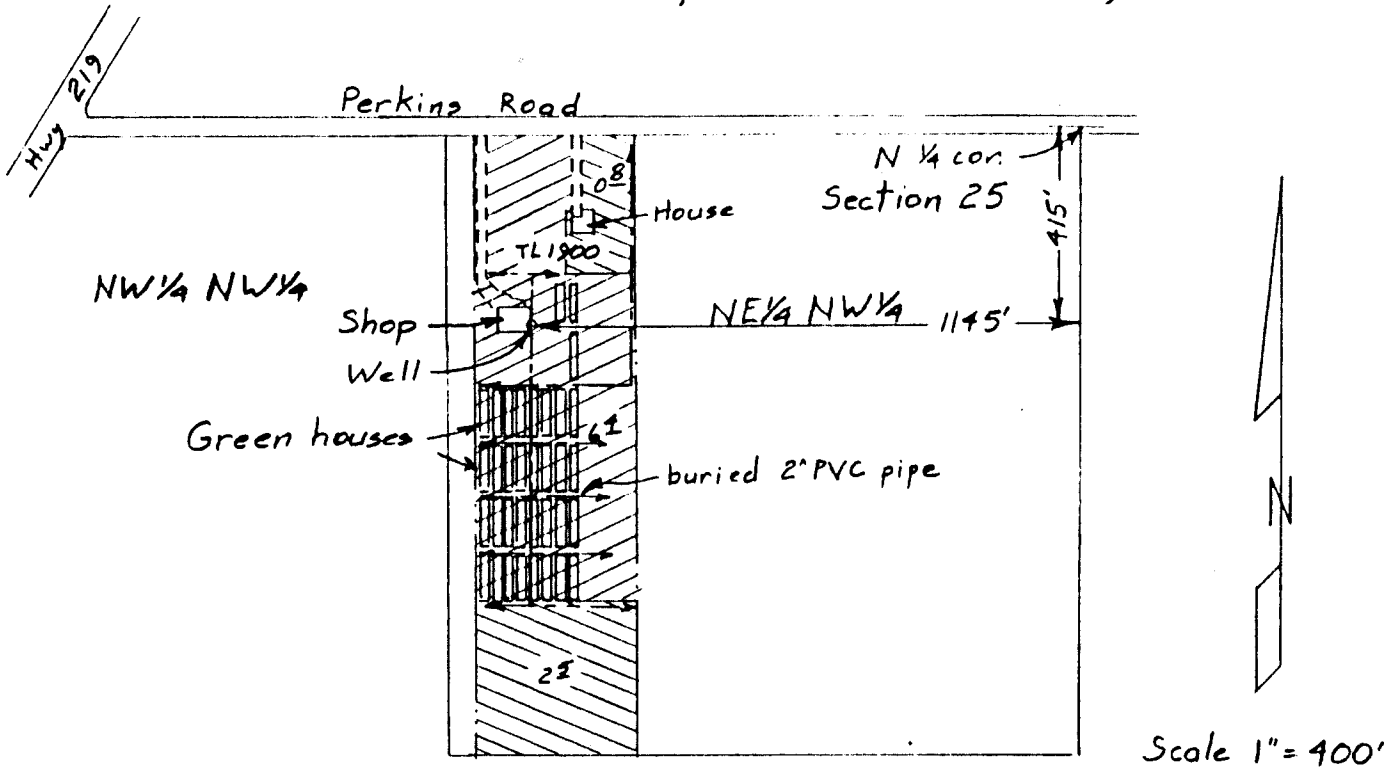


Scale 1" = 400'


- ⊗ Greenhouses & Container Stock 6.4 acres
- ⊗ Irrigation 3.3 acres

Surveyed July 13, 2001

Claim of Beneficial Use Map  
for  
HAROLD TENNANT

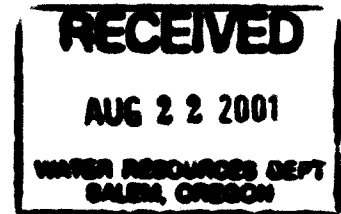

APP G-14256  
Per G-12969

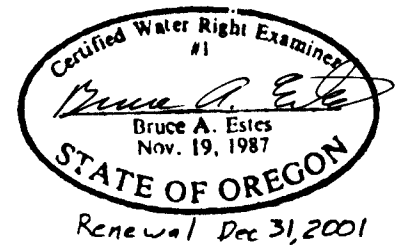

This map is for the purpose of locating a water right only and has no intent to provide legal dimensions or the location of property lines.

**ESTES SURVEYS, LLC**  
 PO Box 17519 60382 Arnold Rd  
 Salem, OR 97305-7519 Bend, OR 97702  
 (503) 585-7593 (541) 382-7391