


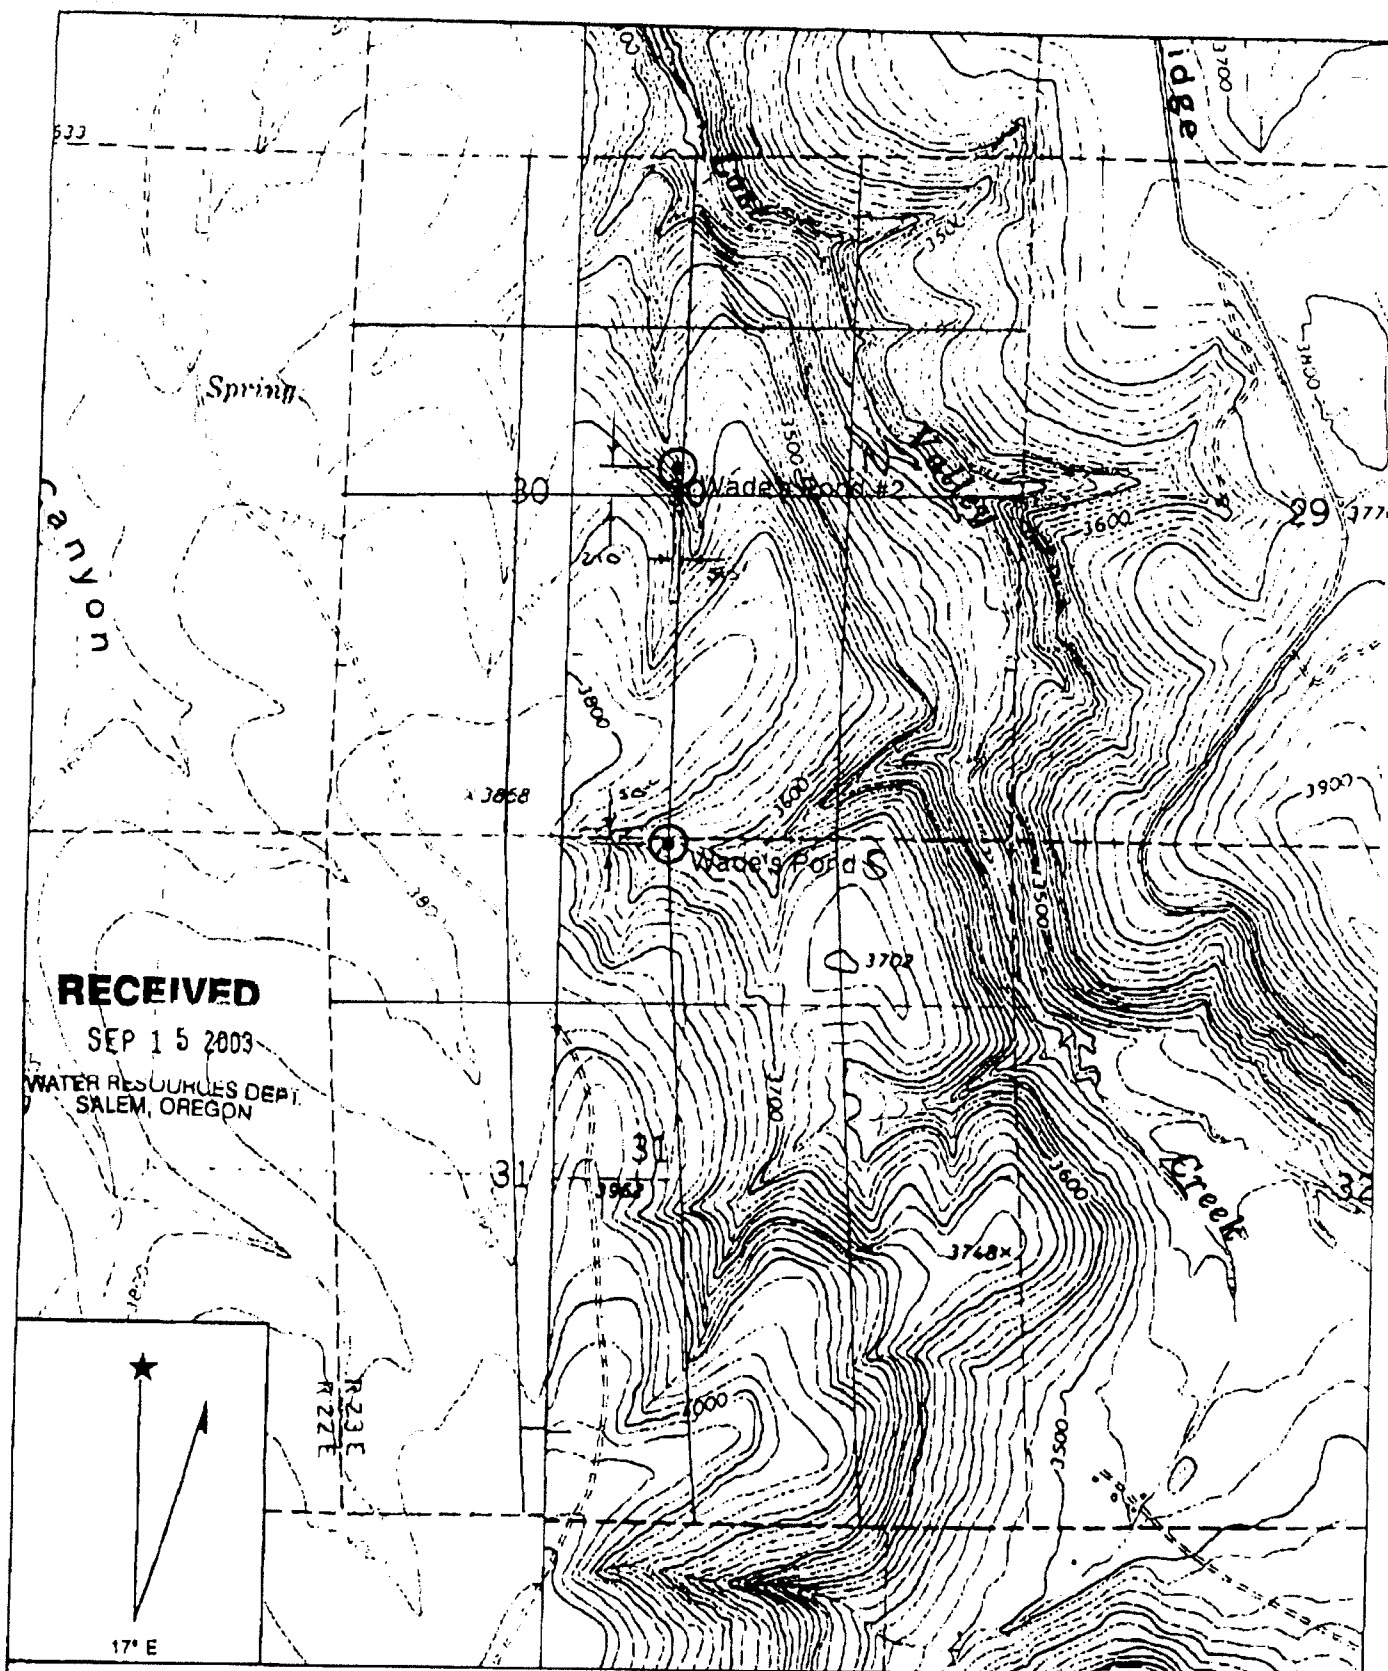

Name: LONEROCK
Date: 9/11/2003
Scale: 1 inch equals 1324 feet

appno R-85796

permit R-13933

Location: 045.0957938° N 119.9854758° W
Caption: Rob Wade
T5S, R23E, W.M.
Tax Lot 2600

RECEIVED BY OWRD

Copyright (C) 1997, Maptech, Inc.

JAN 21 2016

SALEM, OR