


CLAIM OF BENEFICIAL USE MAP FOR
TRANSFER T-8894 IN THE NAME OF
LORRIE WADE
SECTION 6, T2N, R23E, W.M.
MORROW COUNTY

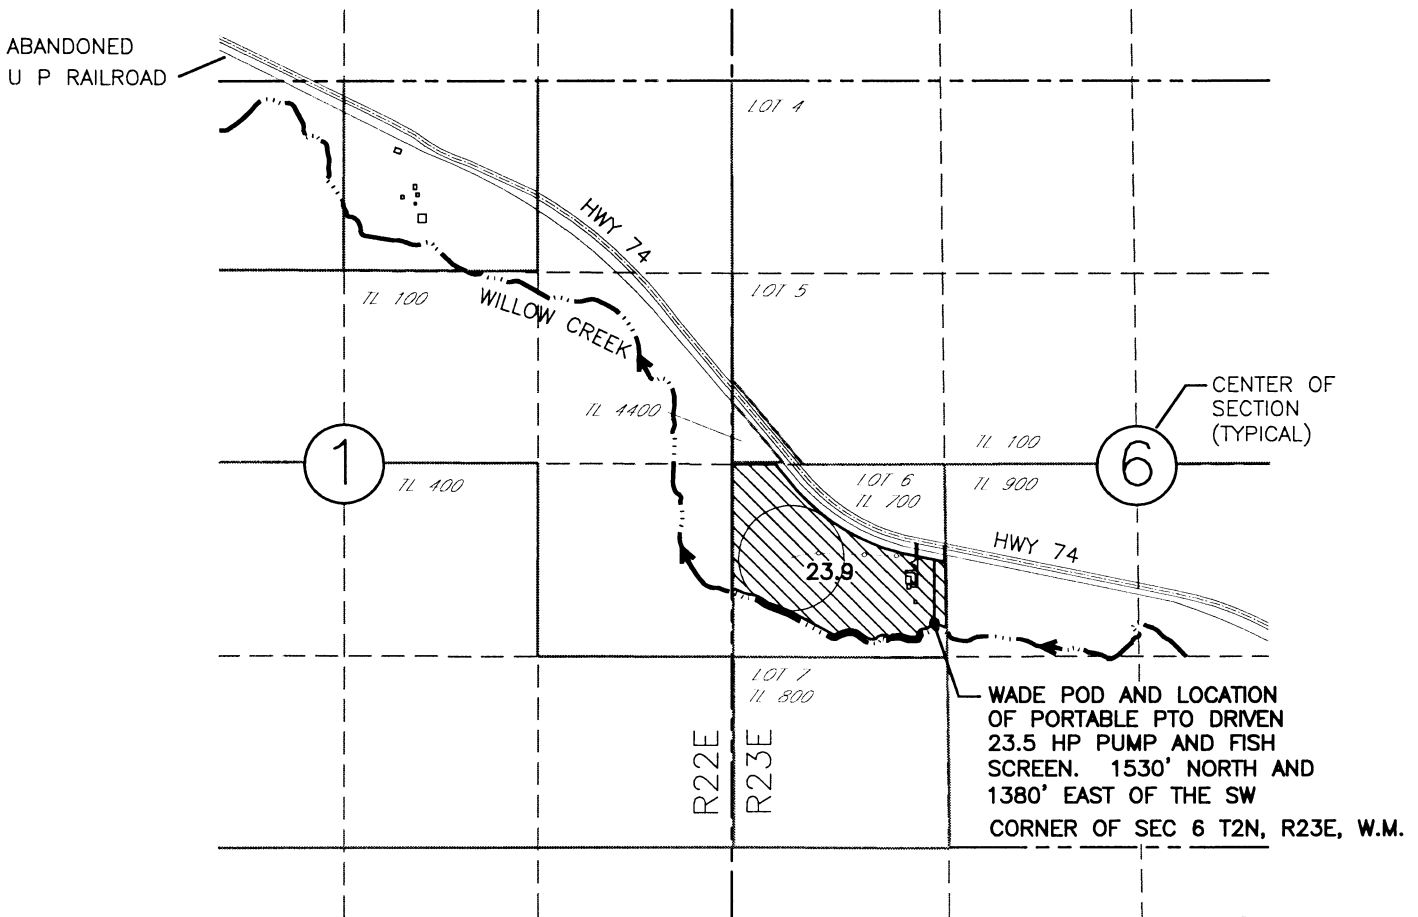

LEGEND



AREA IRRIGATED



POINT OF DIVERSION (POD)





BURIED PIPELINE



TAX LOT BOUNDARY



ABOVE GROUND
PORTABLE PIPELINE

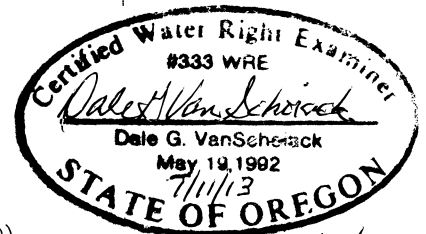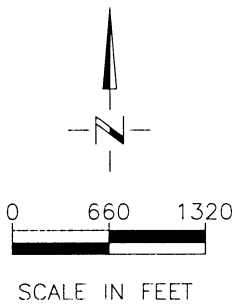

Renews 6/30/14

NOTE:
THE PURPOSE OF THIS MAP IS TO IDENTIFY THE APPROXIMATE LOCATION OF THE WATER RIGHT. IT IS NOT INTENDED TO PROVIDE INFORMATION RELATIVE TO THE LOCATION OF PROPERTY OWNERSHIP BOUNDARY LINES. PIPELINE SIZES AND LOCATIONS WERE PROVIDED BY FARM PERSONNEL AND HAVE NOT BEEN VERIFIED.

DGV Consulting, PLLC
PHONE: (509) 627-8717
E-MAIL: dalevconsulting@gmail.com
1065.001