


T. 25 S., R. 4 W., W.M.

SCALE: 1" = 400'

THE PURPOSE OF THIS MAP IS TO IDENTIFY THE LOCATION OF THE WATER RIGHT. IT IS NOT INTENDED TO PROVIDE INFORMATION RELATIVE TO THE LOCATION OF PROPERTY OWNERSHIP BOUNDARY LINES.

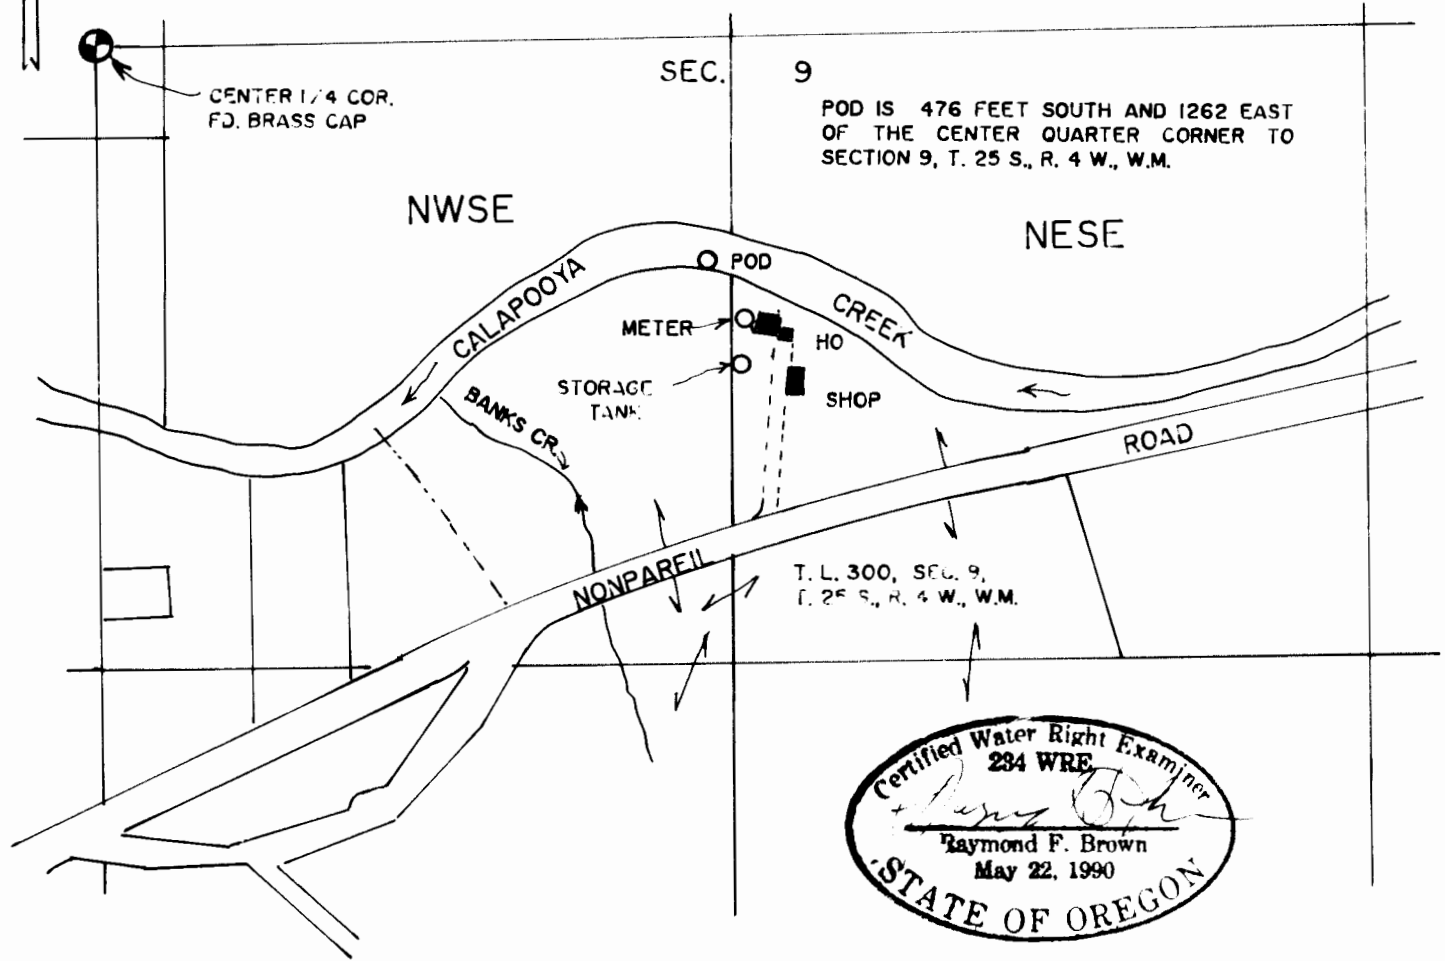

EXP. 12/31/2011

FINAL PROOF SURVEY

UNDER

APPLICATION No. S - 87665

PERMIT No. S - 54723

IN NAME OF

PHYLLIS J. BUTCHER

Surveyed DEC. 19, 2011

By R.F. BROWN