


RECEIVED


JUN 05 2002

WATER RESOURCES DEPT.
SALEM, OREGON

CLAIM OF BENEFICIAL USE SURVEY FOR T-8031 T.34S.,R.2W.,Sec.19 W.M. Jackson County May 28, 2002

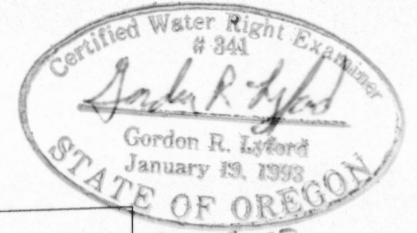

5-28-02
exp 12-31-02

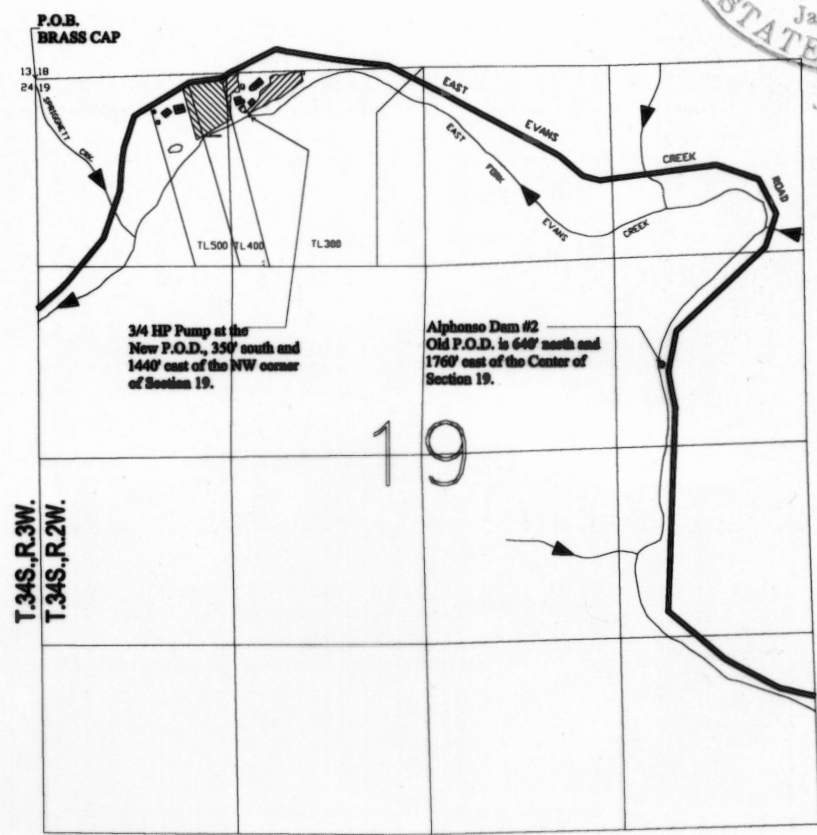

Perfected T-8031 rights with a 1892 priority from East Fork Evans Creek.
0.1 acres in the NW1/4NW1/4, and 1.4 acres in the NE1/4NW1/4 of Section 19.



T-7940 rights with a 1892 priority from East Fork Evans Creek.
0.1 acres in the NE1/4NW1/4, and 1.9 acres in the NW1/4NW1/4 of Section 19.

This map was prepared by Gordon R. Lyford for Katherine Sherrill and Patricia A. Brown who own tax lot 300. They were granted Transfer Order 8031 on February 10, 1999.

This map was prepared for the purposes of identifying the location of water rights only and is not intended to provide legal dimensions or the location of property ownership lines.