

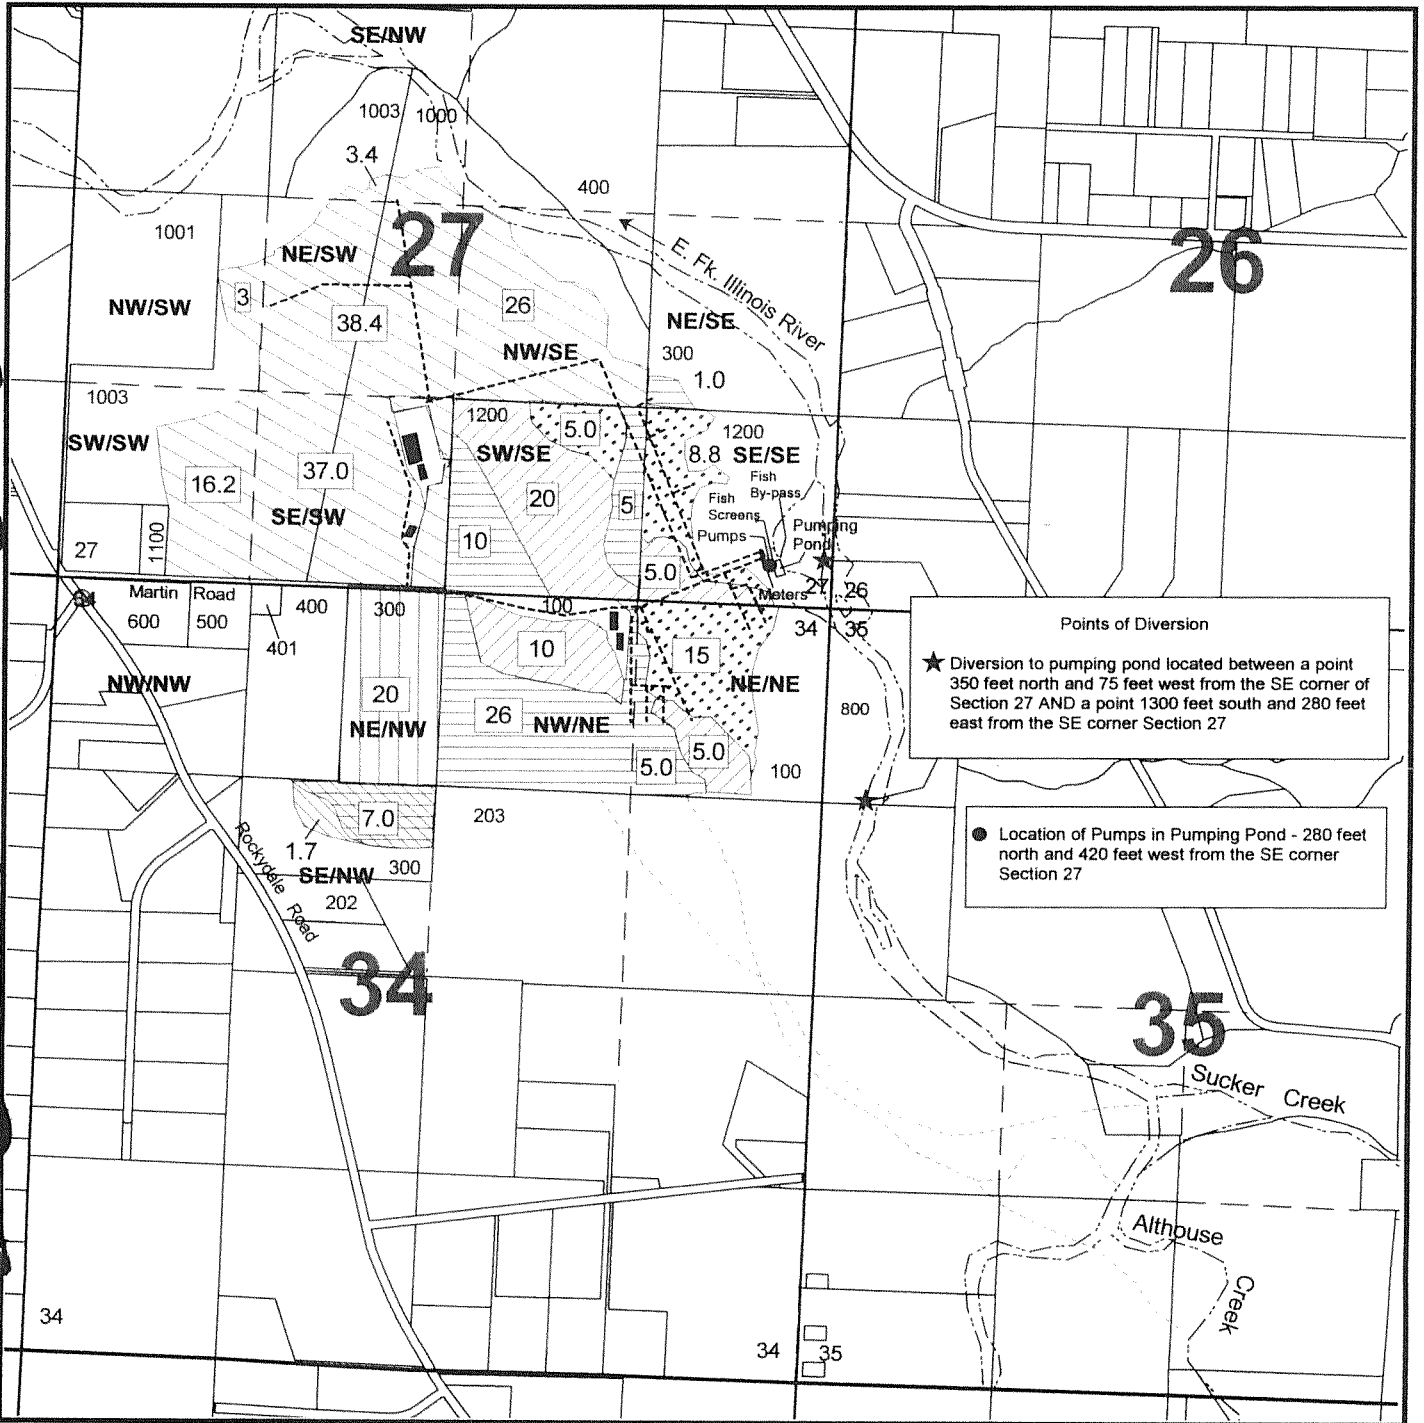
# Claim of Beneficial Use For Transfer T - 8126

Little Elm Ranch, Inc.  
(Jon Bayless)

Josephine County

Township 39 S, Range 8 W, W.M.

COBUC MAP 0345

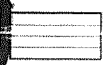

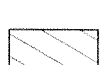

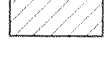



**Points of Diversion**

★ Diversion to pumping pond located between a point 350 feet north and 75 feet west from the SE corner of Section 27 AND a point 1300 feet south and 280 feet east from the SE corner Section 27

● Location of Pumps in Pumping Pond - 280 feet north and 420 feet west from the SE corner Section 27

Scale: 1 inch = 1320 feet

-  C - 79469 (Per - 1107) - 54.0 ac. 3/5/1912
-  C - 6113 (Per-4453) - 20.0 ac. 2/20/1920
-  C - 57716 (Per-1107) - 124.0 ac. 3/5/1912  
(0.6 ac. SE/NW-27 lost due to erosion)  
(0.6 ac. NE/SW-27 lost)
-  C - 2728 - 40.0 ac. Primary; 1900  
C - 19989 - 40.0 ac. Supplemental; 9/19/1947
-  C - 19989 (Permit 17982) - 28.8 ac. Primary. 9/19/1947
-  C - 10110 (Permit - 9359) 1.7 ac. Primary; 7 ac. Supplemental. (1.3 acres primary lost); 10/31/1929
- Main irrigation pipelines (per Smith Irrigation drawing)

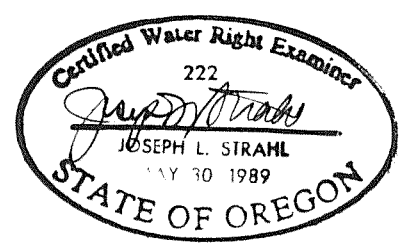


**RECEIVED**

MAY 08 2008

WATER RESOURCES DEPT  
SALEM, OREGON

This map is not intended to provide legal dimensions or locations of property ownership lines.



Public Works Management, Inc.

171 South Second Street  
Central Point, OR 97502

Phone 541 665-5233  
Fax 541 665-5266

Revised  
1/24/2008 n.e.d.

Josephine County GIS data used for base map