

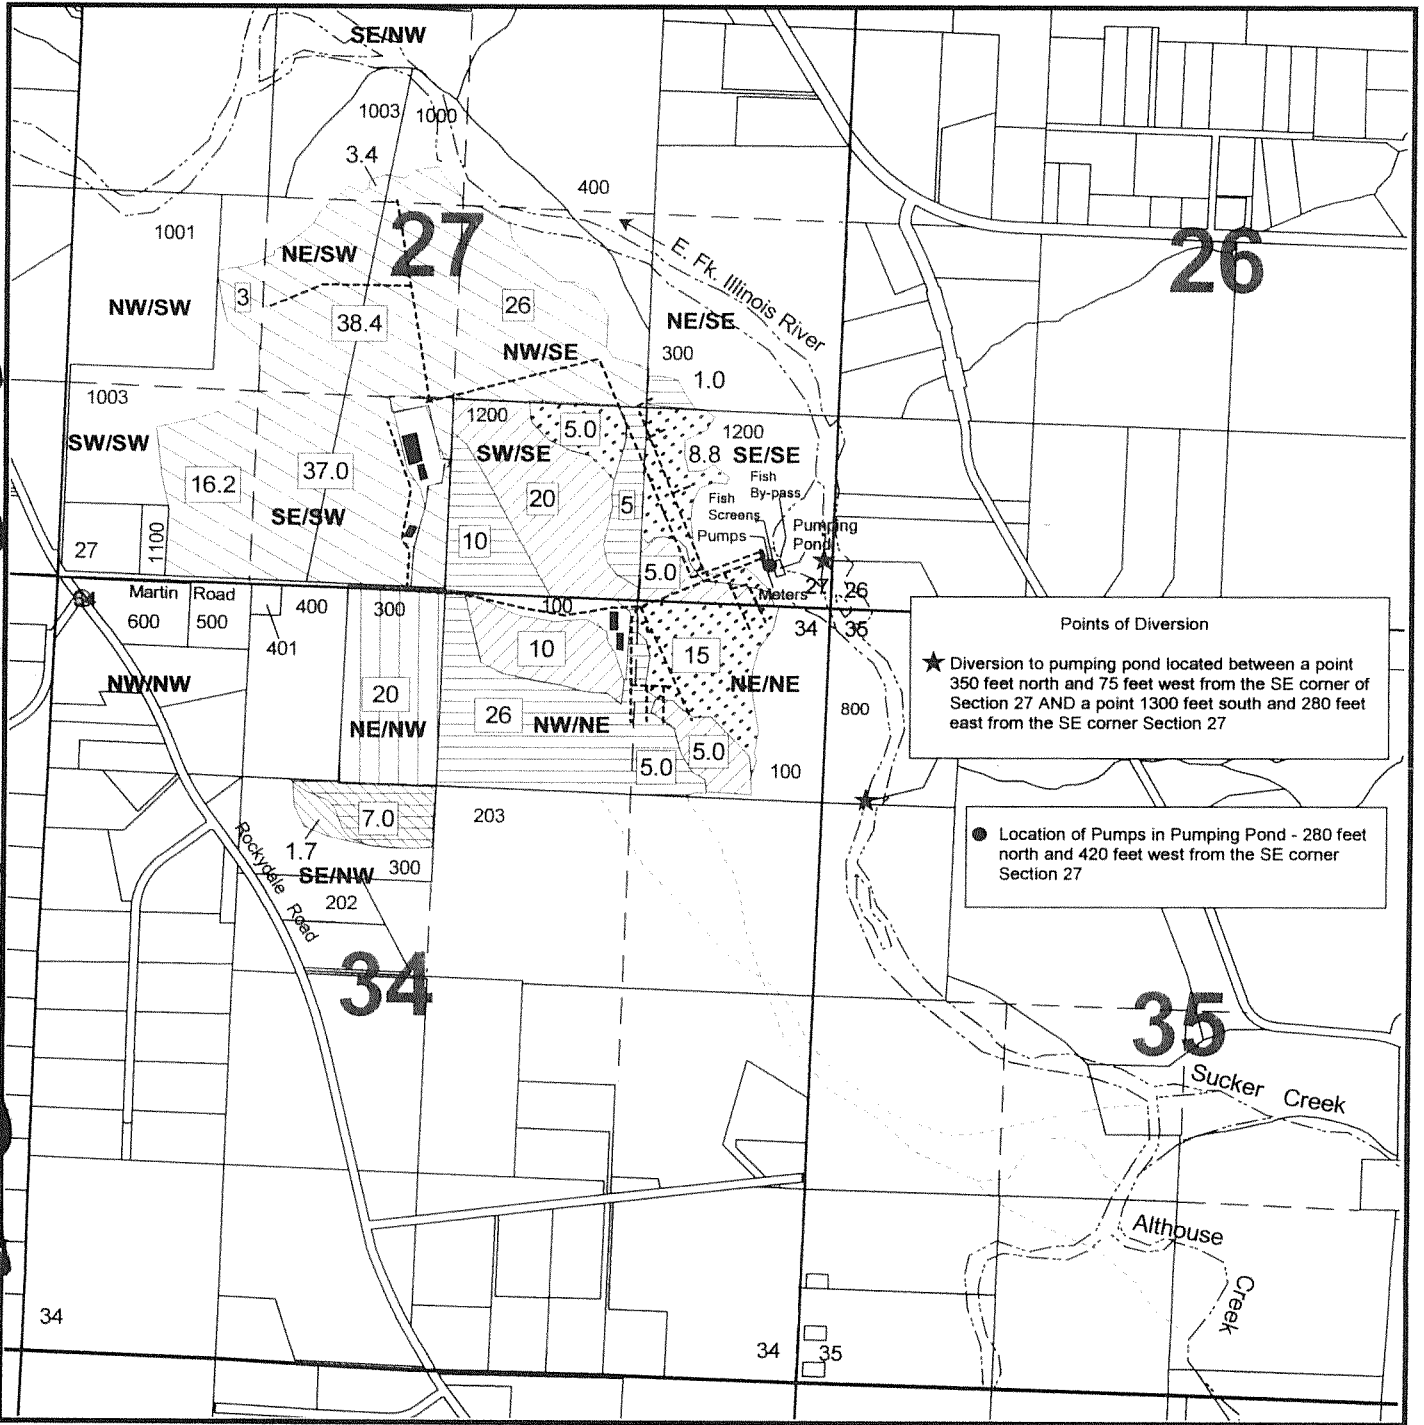
Claim of Beneficial Use For Transfer T - 8126

Little Elm Ranch, Inc.
(Jon Bayless)

Josephine County

Township 39 S, Range 8 W, W.M.

COBUC MAP 0345

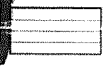

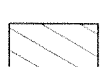

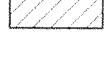
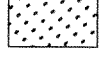


Points of Diversion

★ Diversion to pumping pond located between a point 350 feet north and 75 feet west from the SE corner of Section 27 AND a point 1300 feet south and 280 feet east from the SE corner Section 27

● Location of Pumps in Pumping Pond - 280 feet north and 420 feet west from the SE corner Section 27

Scale: 1 inch = 1320 feet

-  C - 79469 (Per - 1107) - 54.0 ac. 3/5/1912
-  C - 6113 (Per-4453) - 20.0 ac. 2/20/1920
-  C - 57716 (Per-1107) - 124.0 ac. 3/5/1912
(0.6 ac. SE/NW-27 lost due to erosion)
(0.6 ac. NE/SW-27 lost)
-  C - 2728 - 40.0 ac. Primary; 1900
C - 19989 - 40.0 ac. Supplemental; 9/19/1947
-  C - 19989 (Permit 17982) - 28.8 ac. Primary. 9/19/1947
-  C - 10110 (Permit - 9359) 1.7 ac. Primary; 7 ac. Supplemental. (1.3 acres primary lost); 10/31/1929
- Main irrigation pipelines (per Smith Irrigation drawing)

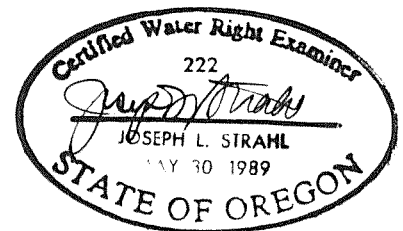


RECEIVED

MAY 08 2008

**WATER RESOURCES DEPT
SALEM, OREGON**

This map is not intended to provide legal dimensions or locations of property ownership lines.



Public Works Management, Inc.

171 South Second Street
Central Point, OR 97502

Phone 541 665-5233
Fax 541 665-5266

Josephine County GIS data used for base map

Revised
1/24/2008 n.e.d.