


T5N, R36E, WM  
Sections 18 & 19  
Umatilla County

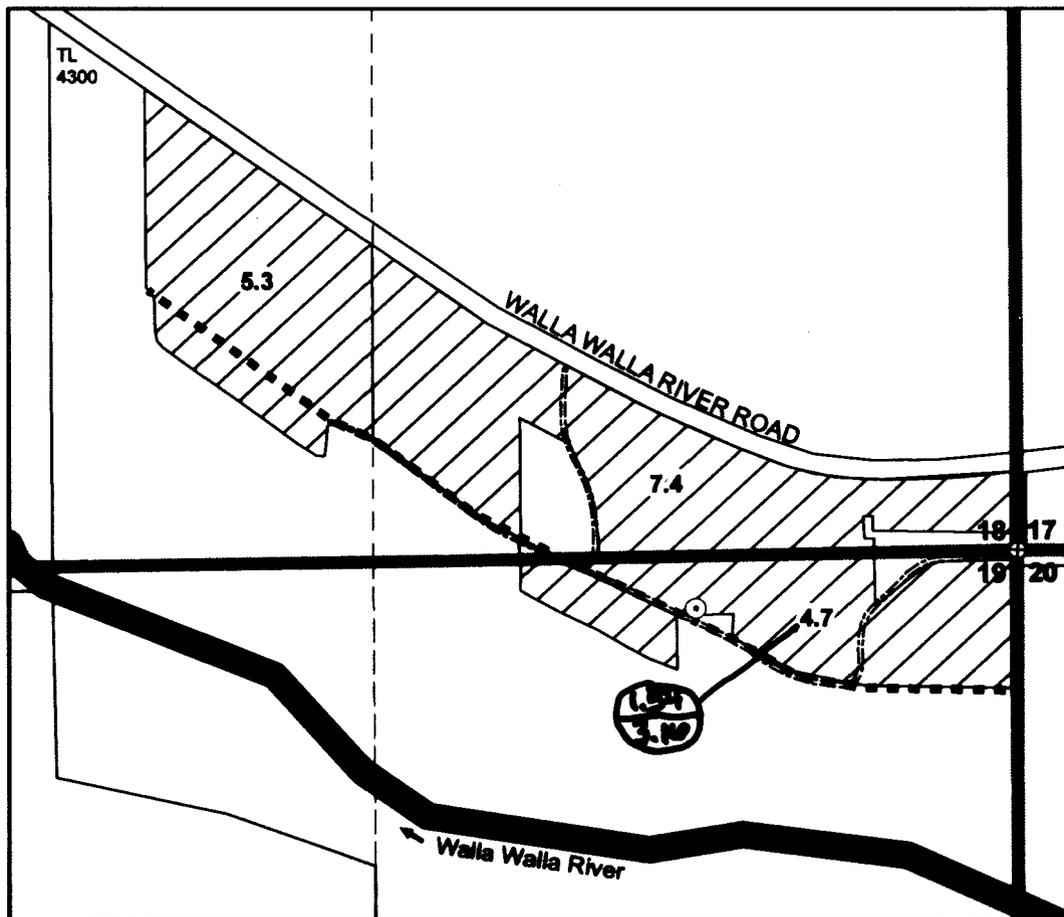

1 inch = 400 feet



⊙ **Point of Appropriation**

Groundwater well (basalt) located in the NE/4, NE/4, Section 19, 135 feet S and 670 feet W from NE Corner of Section 19. Well Log UMAT 4021. Flowmeter present at same location.

----- **Conveyance**

Water conveyed with 5-inch mainline and applied with drip, solid-set and portable sprinklers. Water beneficially used for irrigation of blueberries and raspberries.



**Place of Use**

17.4 acres in Tax Lot 4300, including:  
5.3 acres in SW SE of Section 18  
7.4 acres in SE SE of Section 18  
4.7 acres in NE NE of Section 19

**RECEIVED**


**JAN 19 2010**

**WATER RESOURCES DEPT  
SOLEM, OREGON**



*CF* = confirming right 27100  
*RR* = remaining right 89130

The purpose of this map is to identify the location of a water right. It is not intended to provide information regarding the location of property ownership boundary lines.

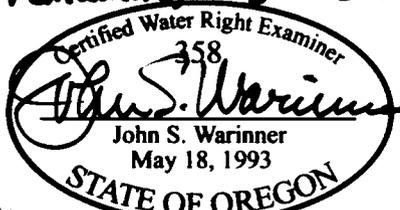

FOUNTAINHEAD  
1204 Alvarado Terrace  
Walla Walla, WA 99362  
509.529.2646 phone

**CLAIM OF BENEFICIAL USE  
Transfer 8891**

in the name of  
CLARK & LYLA LAMPSON

Revised 13 JAN 2010

This map has been amended by WRP to distinguish between the acreage under the Confirming Certificate (27100) and the remaining right certificate (89130). 8-22-10 Joyce/WRP