


877


Claim of Beneficial Use T-11384

For a parcel of land situated in the S 1/2 of Sec. 4 and the N 1/2 of Sec. 9, T16S, R11E, W.M., Deschutes County, Oregon
Tax Lot 803, Map 16-11-04

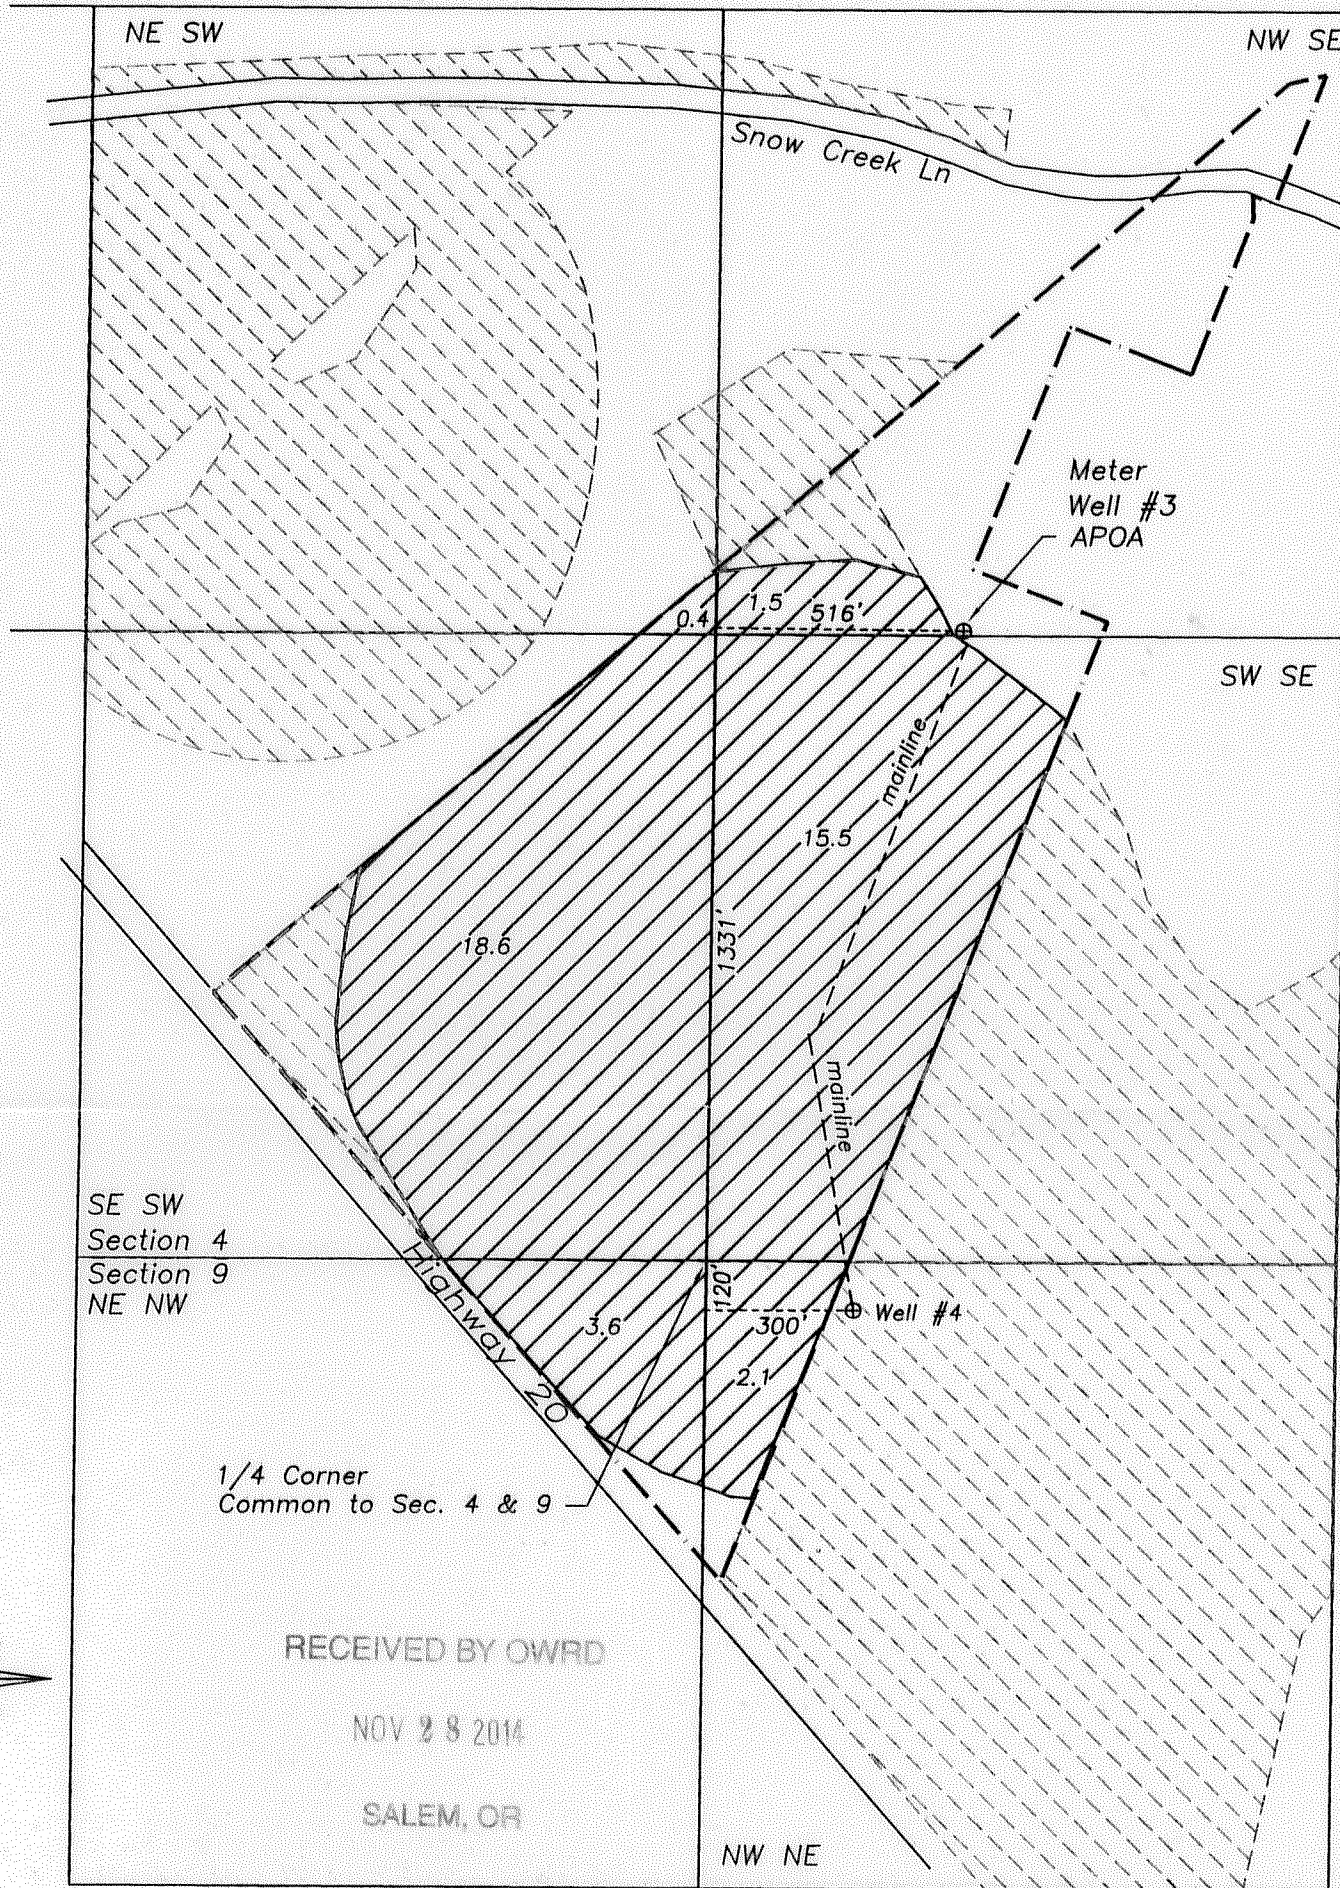

COBU MAP # 877

T16S R11E, W.M.
Deschutes Co. Oregon

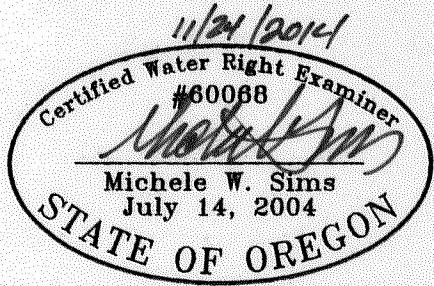

Renewal date: 6/30/2016

Legend




Water beneficially used under T-11384
(Priority 8/31/1992)



Water remaining (Certificate 83456,
priority 8/31/1992)



Property line

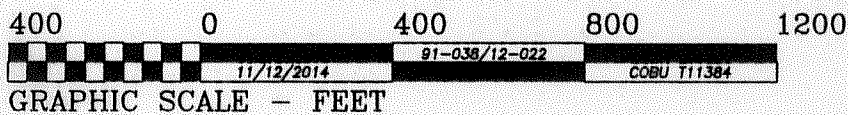

GRAPHIC SCALE - FEET

THIS MAP IS FOR THE PURPOSE OF IDENTIFYING THE LOCATION OF THE WATER RIGHT. IT IS NOT INTENDED TO PROVIDE LEGAL DIMENSIONS OR LOCATIONS OF PROPERTY OWNERSHIP LINES.