



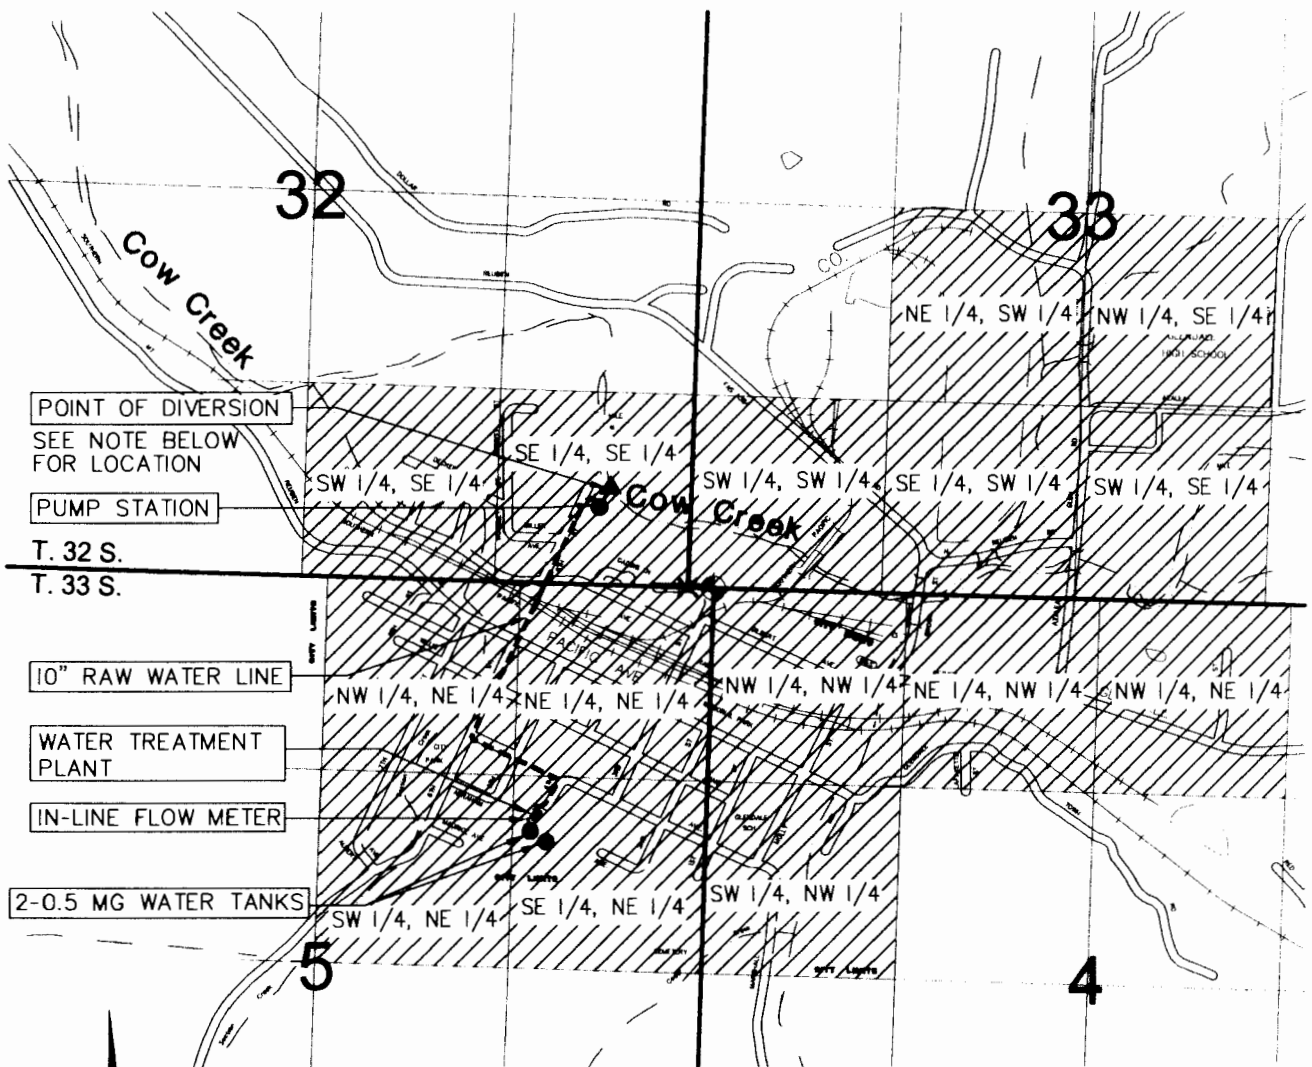

THE DIVERSION POINT IS LOCATED 580 FEET NORTH AND 745 FEET WEST FROM THE NORTHEAST CORNER OF SECTION 5, T. 33 S., R. 6 W., W.M.

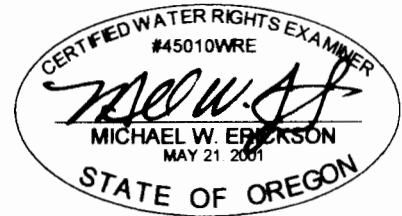

RECEIVED

FEB 25 2008

**WATER RESOURCES DEPT
SALEM, OREGON**

EXPIRATION DATE: 12-31-09

THIS MAP WAS PREPARED FOR THE PURPOSE OF IDENTIFYING THE LOCATION OF A WATER RIGHT ONLY AND IS NOT INTENDED TO PROVIDE LEGAL DIMENSIONS OR LOCATION OF PROPERTY OWNERSHIP.

T. 32 S. & T. 33 S., R. 6 W., W. M.

THE DYER PARTNERSHIP
ENGINEERS & PLANNERS, INC.

DATE: FEB., 2008
PROJECT NO.: 152.00C

**CITY OF GLENDALE - CLAIM OF BENEFICIAL USE
APPLICATION T-8515**

POINT OF DIVERSION & PLACE OF USE MAP

FIGURE NO.

1