

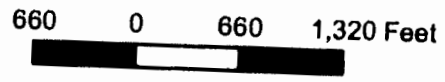



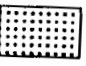
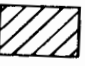
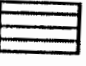


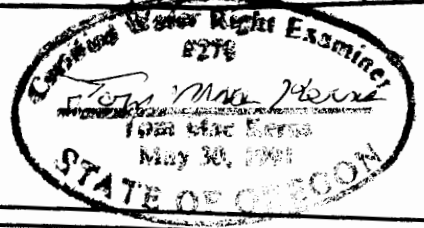


# Richard Stephens COBU Map T-10600

Disclaimer: This map is not intended to provide legal dimensions or location of property ownership lines.

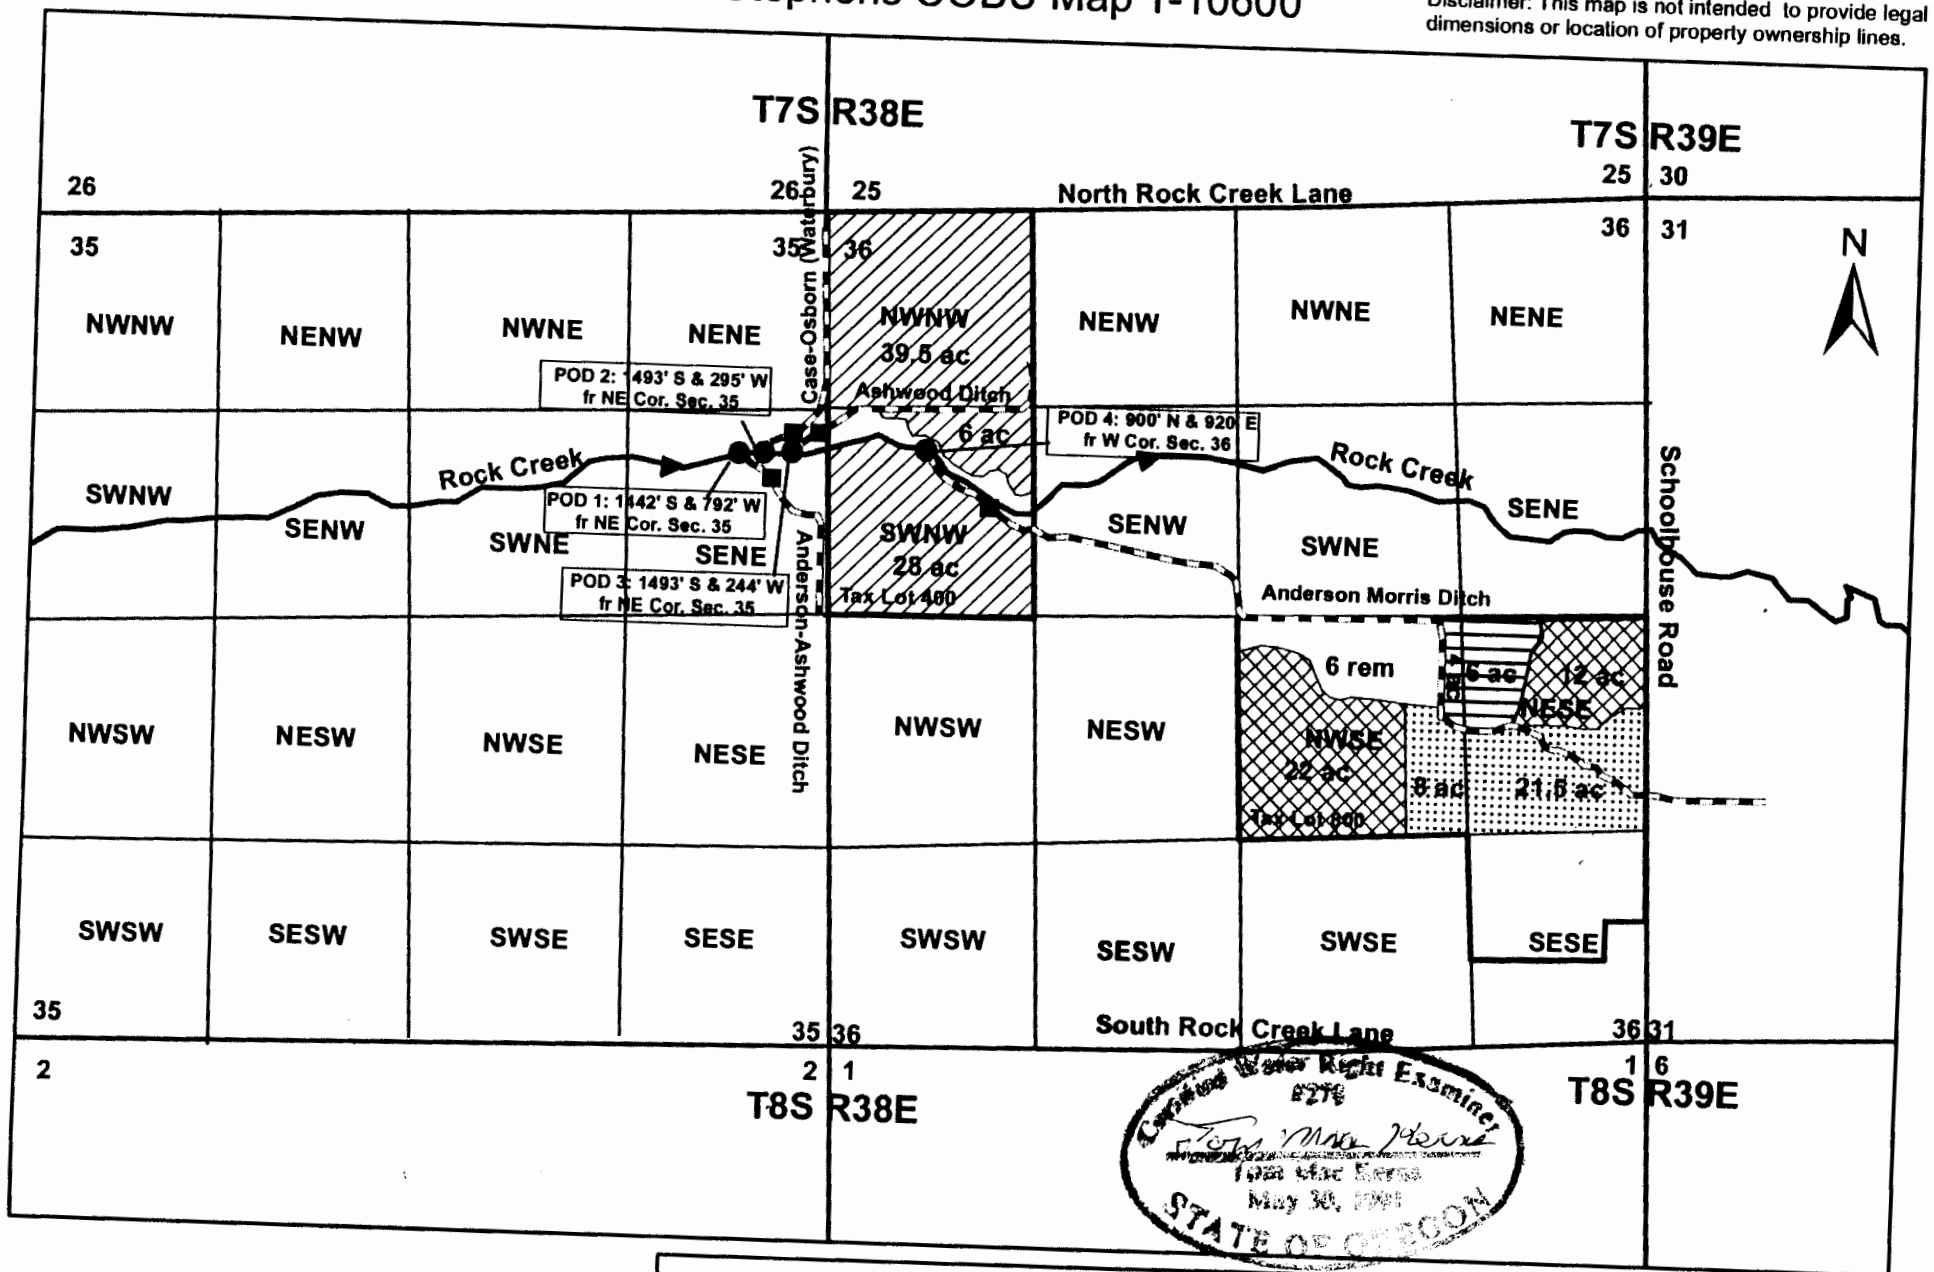

ASF: 7/21/2011

## LEGEND

-  C-82336: 4/1891  
Anderson-Morris Ditch: 34 ac
-  C-82336: 5/1895  
Anderson-Morris Ditch: 29.5 ac
-  C-84857: 1882  
Case-Osborn, Ashwood,  
& Anderson-Morris Ditch: 73.5 ac
-  C-82336: 4/26/1884  
Anderson-Morris Ditch: 10 ac
-  Taxlot Boundaries
-  Ditches
-  Direction of Flow
-  POD's
-  Wier Locations