


LEGEND

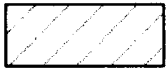

Lands irrigated by Additional P.O.D.

RECEIVED

OCT 05 2009

SCALE: 1"=1320'

WATER RESOURCES DEPT
SALEM, OREGON

SEPTEMBER 21, 2009


----- Lateral irrigation ditches.

**FINAL PROOF MAP OF
ADDITIONAL POINT OF DIVERSION**

FOR

WILLIAMS DITCH COMPANY

Site Survey, September 29, 2008

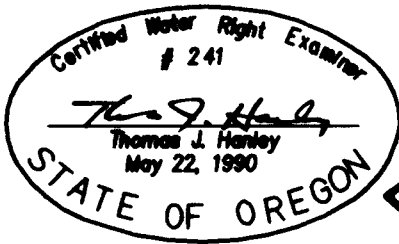

HANLEY

APPLICATION NO. T-9379

PERMIT NUMBER T-9379

This map is for the purpose of identifying the water right location only and is not intended to provide legal dimensions or location of property ownership lines.

HANLEY ENGINEERING INC.
2043 MAIN STREET
BAKER CITY, OREGON