

FINAL PROOF SURVEY
AND
CLAIM OF BENEFICIAL USE
LOCATED WITHIN
NW 1/4, NE 1/4 SECTION 36, T.2S., R.24E., W.M.,
MORROW COUNTY, OREGON
ADDITIONAL POINT OF DIVERSION
APPLICANT: MALCOLM FRED HOSKINS


RECEIVED

NOV 24 2005

WATER RESOURCES DEPT
SALEM, OREGON

TRANSFER 6839


SPECIAL ORDER VOLUME 55, PAGE 1,245

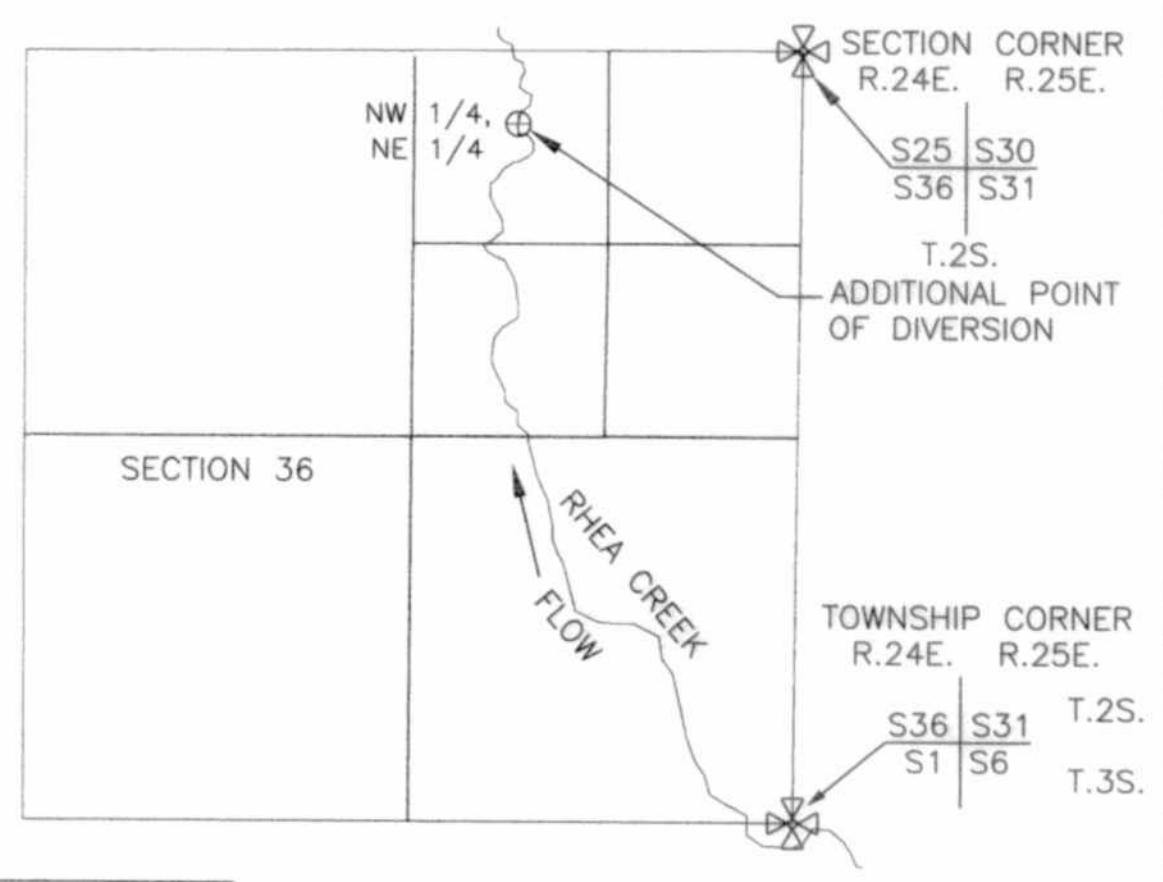

LEGEND


- SECTION LINE
- 1/16TH LINE
- SECTION CORNER
- ADDITIONAL POINT OF DIVERSION

CORNER TIE:
THE ADDITIONAL POINT OF
DIVERSION IS WITHIN THE NW
1/4, NE 1/4, SECTION 36, T2S.,
R.24E., W.M., AND IS 510 FEET
SOUTH AND 1,950 FEET WEST
OF THE NORTHEAST CORNER OF
SAID SECTION 36.

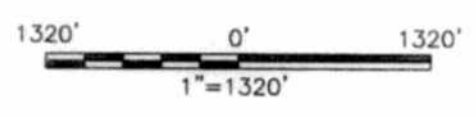

THIS MAP IS PREPARED
FOR THE EXPRESS
PURPOSE TO SHOW WATER
APPROPRIATION AND USE.
IT IS NOT INTENDED TO
SHOW OR LOCATE
PROPERTY OWNERSHIP
LINES.

©

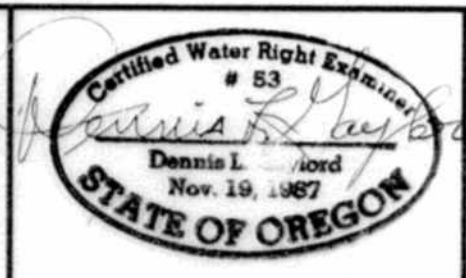


Renews 6/30/2005

DENNIS L. GAYLORD,
CWRE
71614 S.W. LAKE DRIVE
PENDLETON, OR 97801
(541)-276-6260
NOVEMBER, 2003
Mill Creek Drafting

Application for transfer
for POD in name of
Malcolm Fred Hoskins

 Hoskins

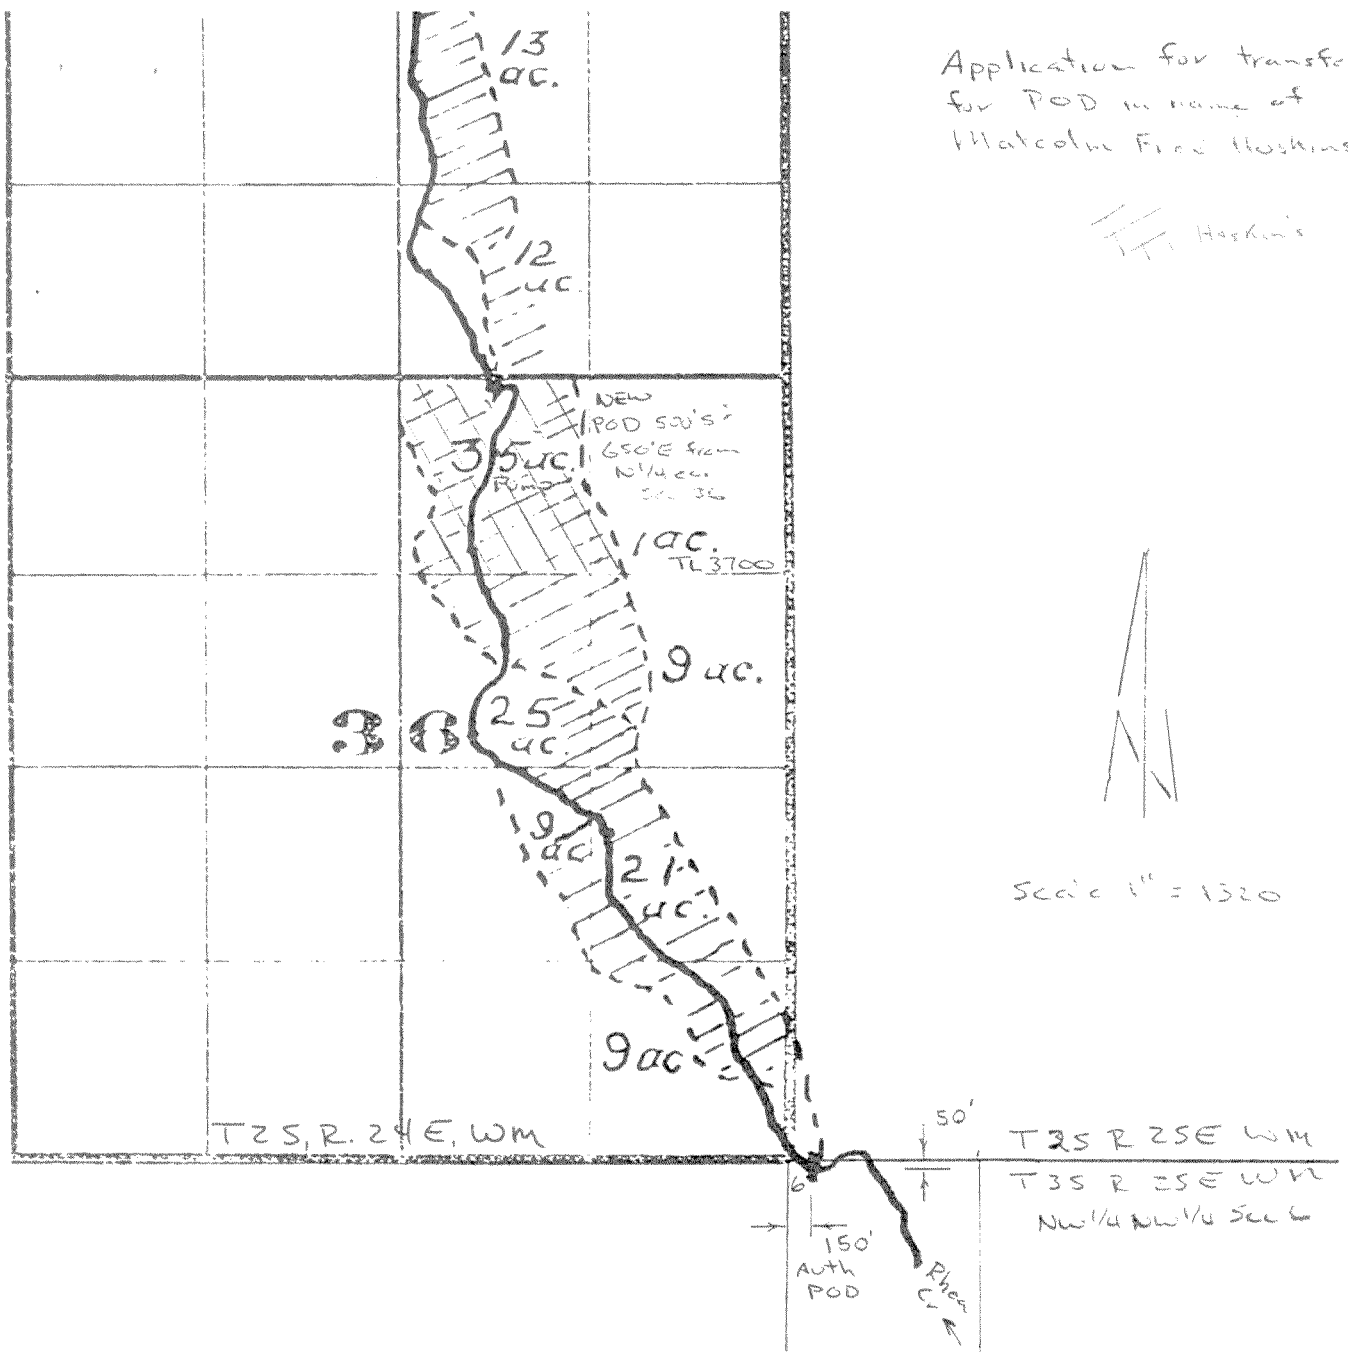

Approved by Malcolm Hoskins on
12-13-70
V. Chet