


# T.5S. R.1E. Sec. 12, W.M.

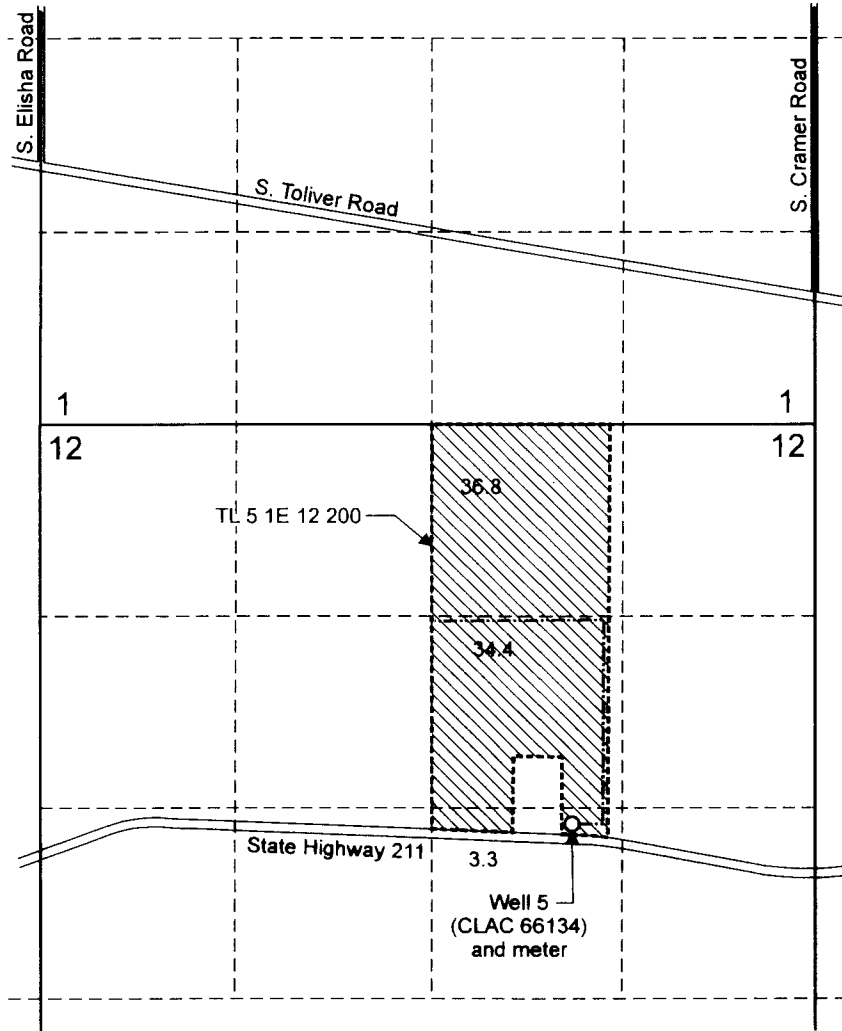


Well 5 (CLAC 66134) is located 2,750 feet south and 1,660 feet west from the NE corner of Section 12.

 Area (74.5 Acres) irrigated under Application G-17162, Permit G-16545.


 Tax lot boundary

 Irrigation mainline

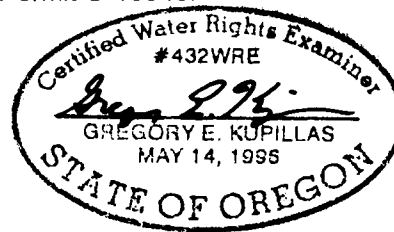

EXPIRATION DATE: 6/30/2013

Scale: 1" = 1,320'

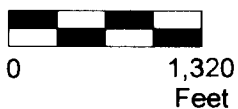

This map was prepared for the purpose of identifying the location of a water right only and is not intended to provide legal dimensions or location of property ownership lines.



Claim of Beneficial Use Map  
Application G-17162, Permit G-16545

Dickman Land, LLC  
T.5S. R.1E. Sec. 12, W.M.

Pacific Hydro-Geology Inc.

12/2011