


EXHIBIT B

T23S, R30E, W.M.
Harney County, Oregon

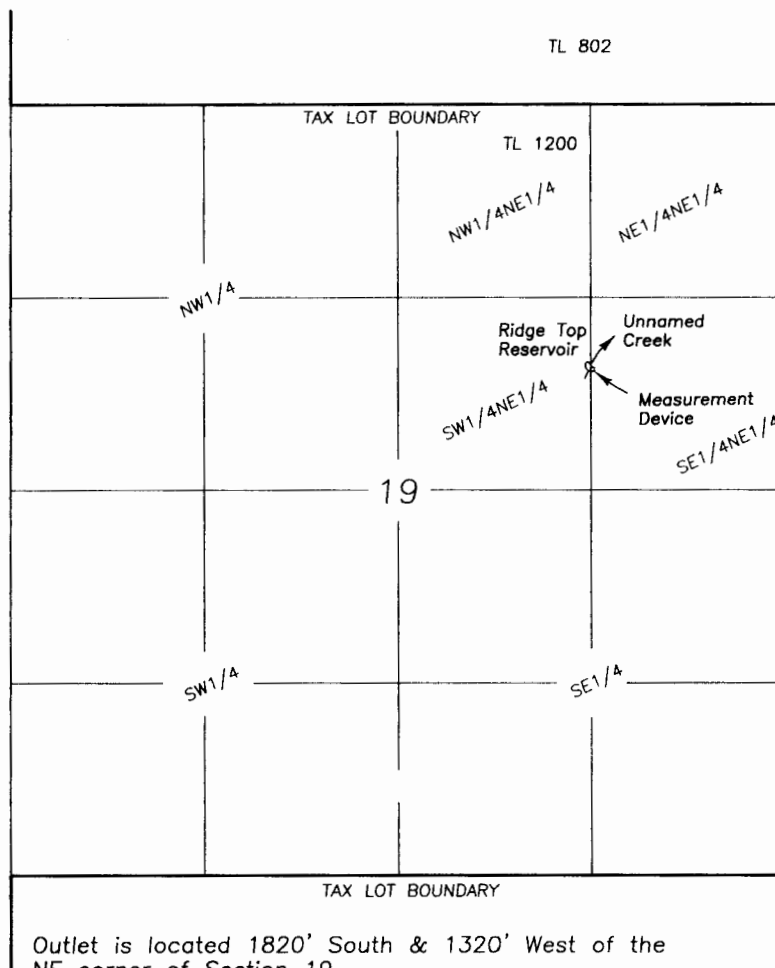

SCALE 1"=1320'

Outlet is located 1820' South & 1320' West of the
NE corner of Section 19.

Measuring device is located 6' North & 11' East of the Outlet

**FINAL PROOF SURVEY
CLAIM OF BENEFICIAL USE
RIDGE TOP RESERVOIR**

LEGEND

Application No. R-59642
Permit No. R-8077
Priority 12/21/1979

A portion of Tax Lot
23-30 TL1200

NOTE: Tax Lot 1200 is owned by the BLM
and is more that 1700 acres.
Therefore only a portion of the tax
lot boundary can be shown.

NOTE: The preparation of this map
was for the purpose of identifying
the location of the proposed water
right and has no intent to provide
dimensions or location of property
ownership lines.

For

Bureau of Land Managment

August 9, 2016

Prepared by

Cornerstone Surveying, Inc

P.O. BOX 33

JOHN DAY, OR. 97845

(541)575-1813

cornerstonesurvey@centurytel.net

RECEIVED BY OWRD

AUG 29 2016

SALEM, OR

