


EXHIBIT A

T22S, R33E, W.M.
Harney County, Oregon

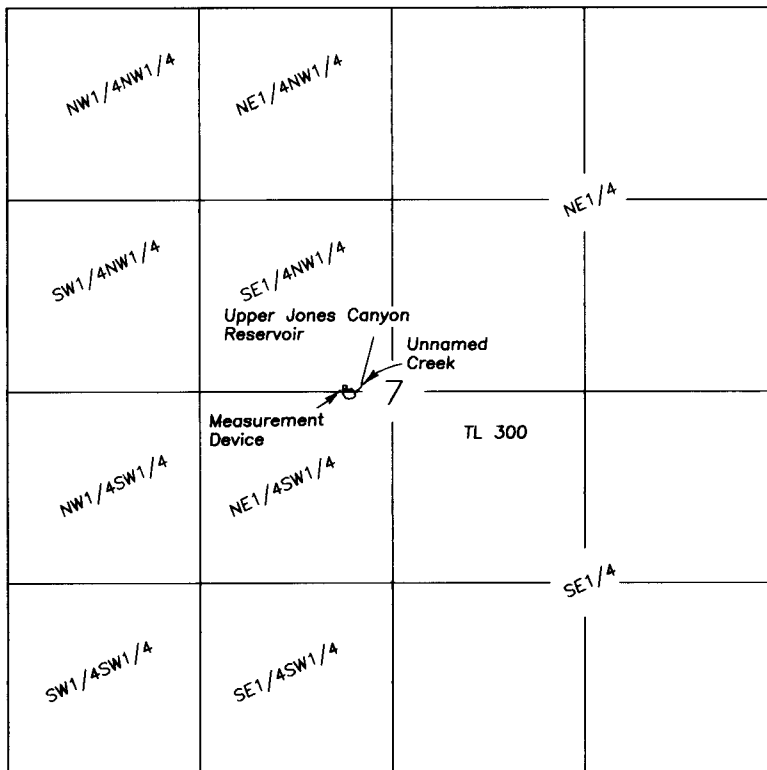

SCALE 1"=1320'

RECEIVED BY OWRD

AUG 29 2016

SALEM, OR

No outlet was constructed. The inlet is located 2650' South
& 2900' West of the NE corner of Section 7.

FINAL PROOF SURVEY
CLAIM OF BENEFICIAL USE
UPPER JONES CANYON RESERVOIR

For

Bureau of Land Management

July 26, 2016

LEGEND

Application No. R-35472

Permit No. R-3335

Priority 7/24/1961

A portion of Tax Lot
22-33 TL300

NOTE: Tax Lot 300 is owned by the BLM
and is more that 8,700 acres.
No boundaries of the tax lot can
be shown.

NOTE: The preparation of this map
was for the purpose of identifying
the location of the proposed water
right and has no intent to provide
dimensions or location of property
ownership lines.

Prepared by

Cornerstone Surveying, Inc

P.O. BOX 33

JOHN DAY, OR. 97845

(541)575-1813

cornerstonesurvey@centurytel.net

