


T23S, R30E, W.M.
Harney County, Oregon

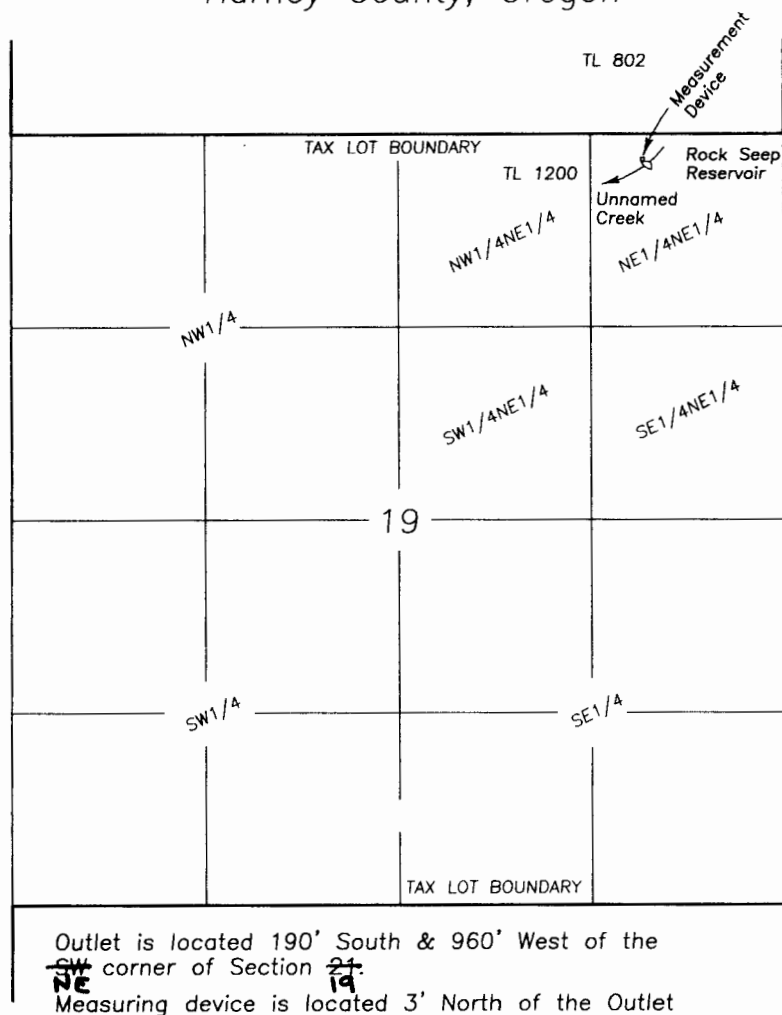

SCALE 1"=1320'

FINAL PROOF SURVEY
CLAIM OF BENEFICIAL USE
ROCK SEEP RESERVOIR

LEGEND

Application No. R-59643
Permit No. R-8078
Priority 12/21/1979

A portion of Tax Lot
23-30 TL1200

NOTE: Tax Lot 1200 is owned by the BLM
and is more that 1700 acres.
Therefore only a portion of the tax
lot boundary can be shown.

For

Bureau of Land Managment
August 9, 2016

Prepared by

Cornerstone Surveying, Inc

P.O. BOX 33

JOHN DAY, OR. 97845

(541)575-1813

cornerstonesurvey@centurytel.net

RECEIVED BY OWRD

AUG 29 2016

SALEM, OR

NOTE: The preparation of this map
was for the purpose of identifying
the location of the proposed water
right and has no intent to provide
dimensions or location of property
ownership lines.

* Revised by OWRD to correctly
show coordinates of the outlet.
-cnn 9/15/16 WRD

