


T24S, R34E, W.M.
Harney County, Oregon

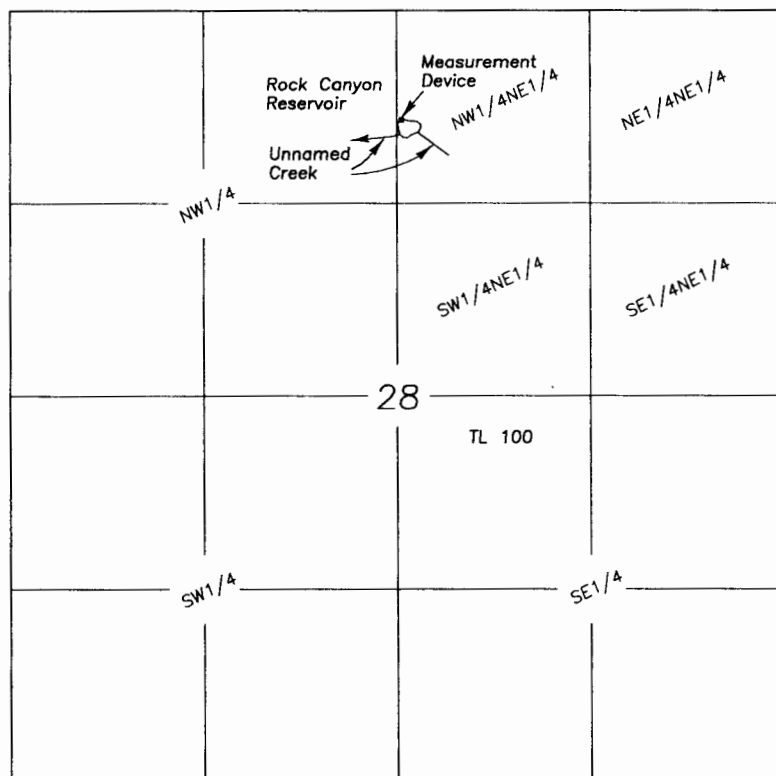

SCALE 1"=1320'

Outlet is located 770' South & 2630' West of the
NE corner of Section 28.

Measuring device is located 5' South & 10' East of the Outlet

**FINAL PROOF SURVEY
CLAIM OF BENEFICIAL USE
ROCK CANYON RESERVOIR**

LEGEND

Application No. R-66490
Permit No. R-11098
Priority 1/16/1985

A portion of Tax Lot
24-34 TL100

NOTE: Tax Lot 100 is owned by the BLM
and is more that 13,000 acres.
No boundaries of the tax lot can
be shown.

For

Bureau of Land Managment

July 22, 2016

Prepared by

Cornerstone Surveying, Inc

P.O. BOX 33

JOHN DAY, OR. 97845

(541)575-1813

cornerstonesurvey@centurytel.net

RECEIVED BY OWRD

AUG 29 2016

SALEM, OR

NOTE: The preparation of this map
was for the purpose of identifying
the location of the proposed water
right and has no intent to provide
dimensions or location of property
ownership lines.

