


T23S, R30E, W.M.
Harney County, Oregon

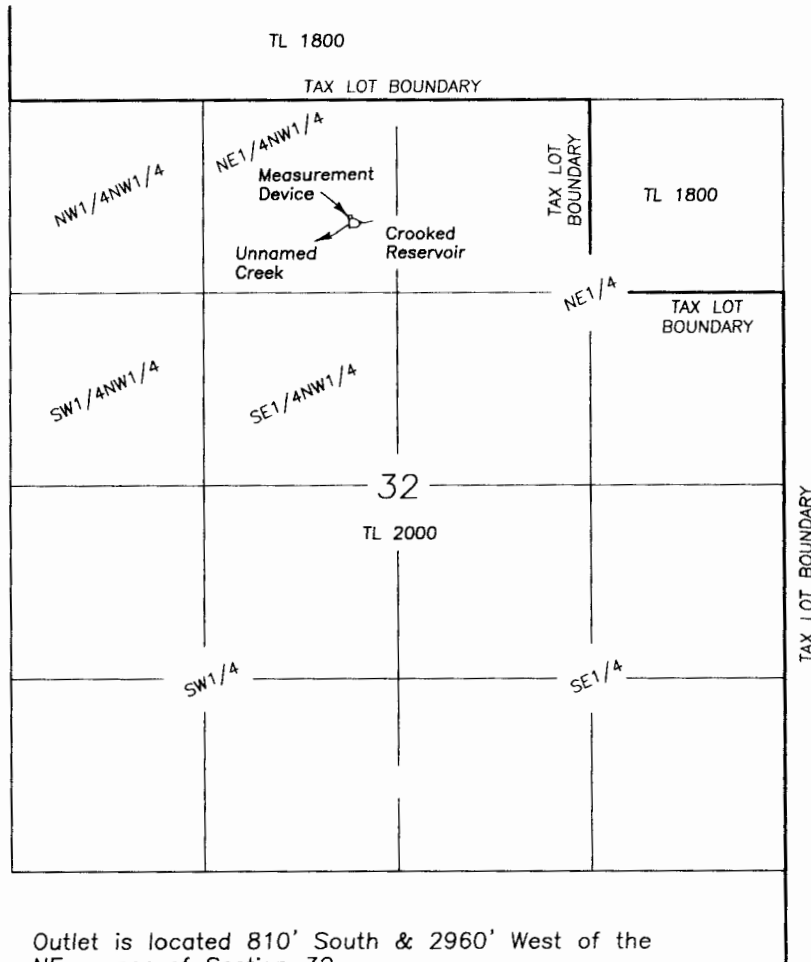

SCALE 1"=1320'

RECEIVED BY OWRD

AUG 29 2016

SALEM, OR

Outlet is located 810' South & 2960' West of the
NE corner of Section 32.

Measuring device is located 2' West of the Outlet

FINAL PROOF SURVEY
CLAIM OF BENEFICIAL USE
CROOKED RESERVOIR

LEGEND

Application No. R-59651
Permit No. R-8083
Priority 12/21/1979

A portion of Tax Lot
23-30 TL 2000

NOTE: Tax Lot 2000 is owned by the BLM
and is more than 1800 acres.
Therefore only a portion of the tax
lot boundary can be shown.

NOTE: The preparation of this map
was for the purpose of identifying
the location of the proposed water
right and has no intent to provide
dimensions or location of property
ownership lines.

For

Bureau of Land Management

August 10, 2016

Prepared by

Cornerstone Surveying, Inc

P.O. BOX 33

JOHN DAY, OR. 97845

(541)575-1813

cornerstonesurvey@centurytel.net

