


T21S, R33E, W.M.
Harney County, Oregon

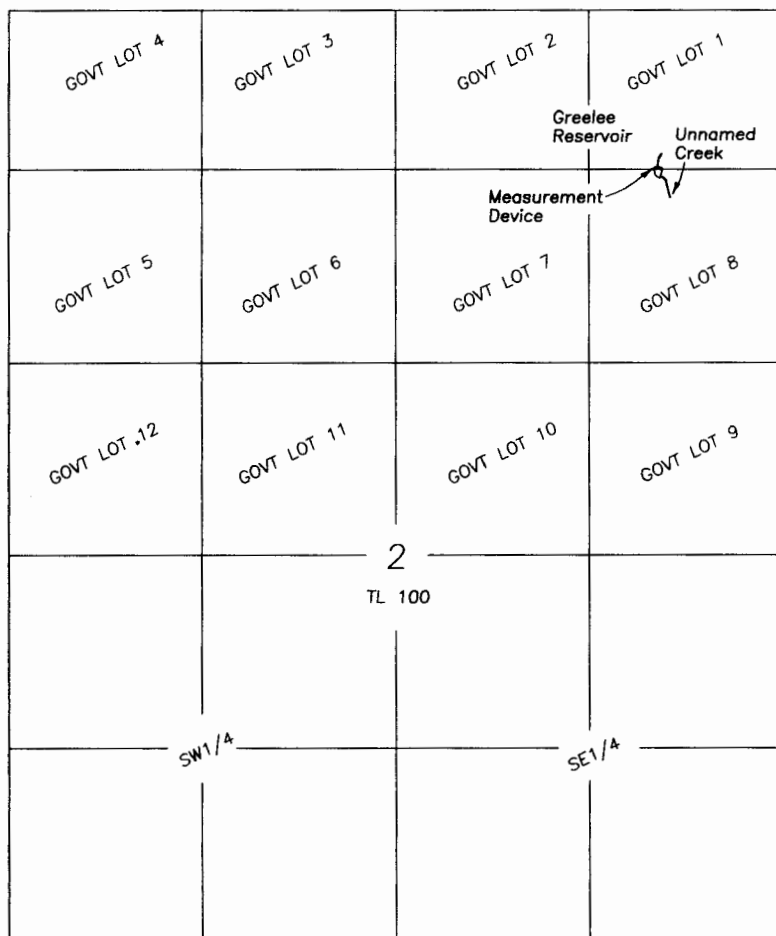

Outlet is located 1090' South & 880' West of the
NE corner of Section 2.

Measuring device is located 5' South of the Outlet.



SCALE 1"=1320'

FINAL PROOF SURVEY
CLAIM OF BENEFICIAL USE
GREELEE RESERVOIR

For

Bureau of Land Management

July 12, 2016

Prepared by

Cornerstone Surveying, Inc

P.O. BOX 33

JOHN DAY, OR. 97845

(541)575-1813

cornerstonesurvey@centurytel.net

LEGEND

Application No. R-66480

Permit No. R-11094

Priority 1/16/1985

A portion of Tax Lot
21-33-01 TL100

NOTE: Tax Lot 100 is owned by the BLM
and is more that 11,000 acres.
No boundaries of the tax lot
can be shown.

RECEIVED BY OWRD

AUG 29 2016

SALEM, OR

NOTE: The preparation of this map
was for the purpose of identifying
the location of the proposed water
right and has no intent to provide
dimensions or location of property
ownership lines.

