

0632

Claim of Beneficial Use

In The Name of

B. Rune & Catherine Lassenen

CLAIM OF BENEFICIAL USE:

HUMAN CONSUMPTION - 2 HOUSEHOLDS

Per COBU attachment-1, non-commercial garden not to exceed 0.5 AC each limited.

Application: S-73266



Permit: S-52303

T29S-R03W-S32 & S33

Tax Lot: 300 & 500

T30S-R03W-S4


Tax Lot: 400

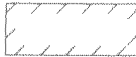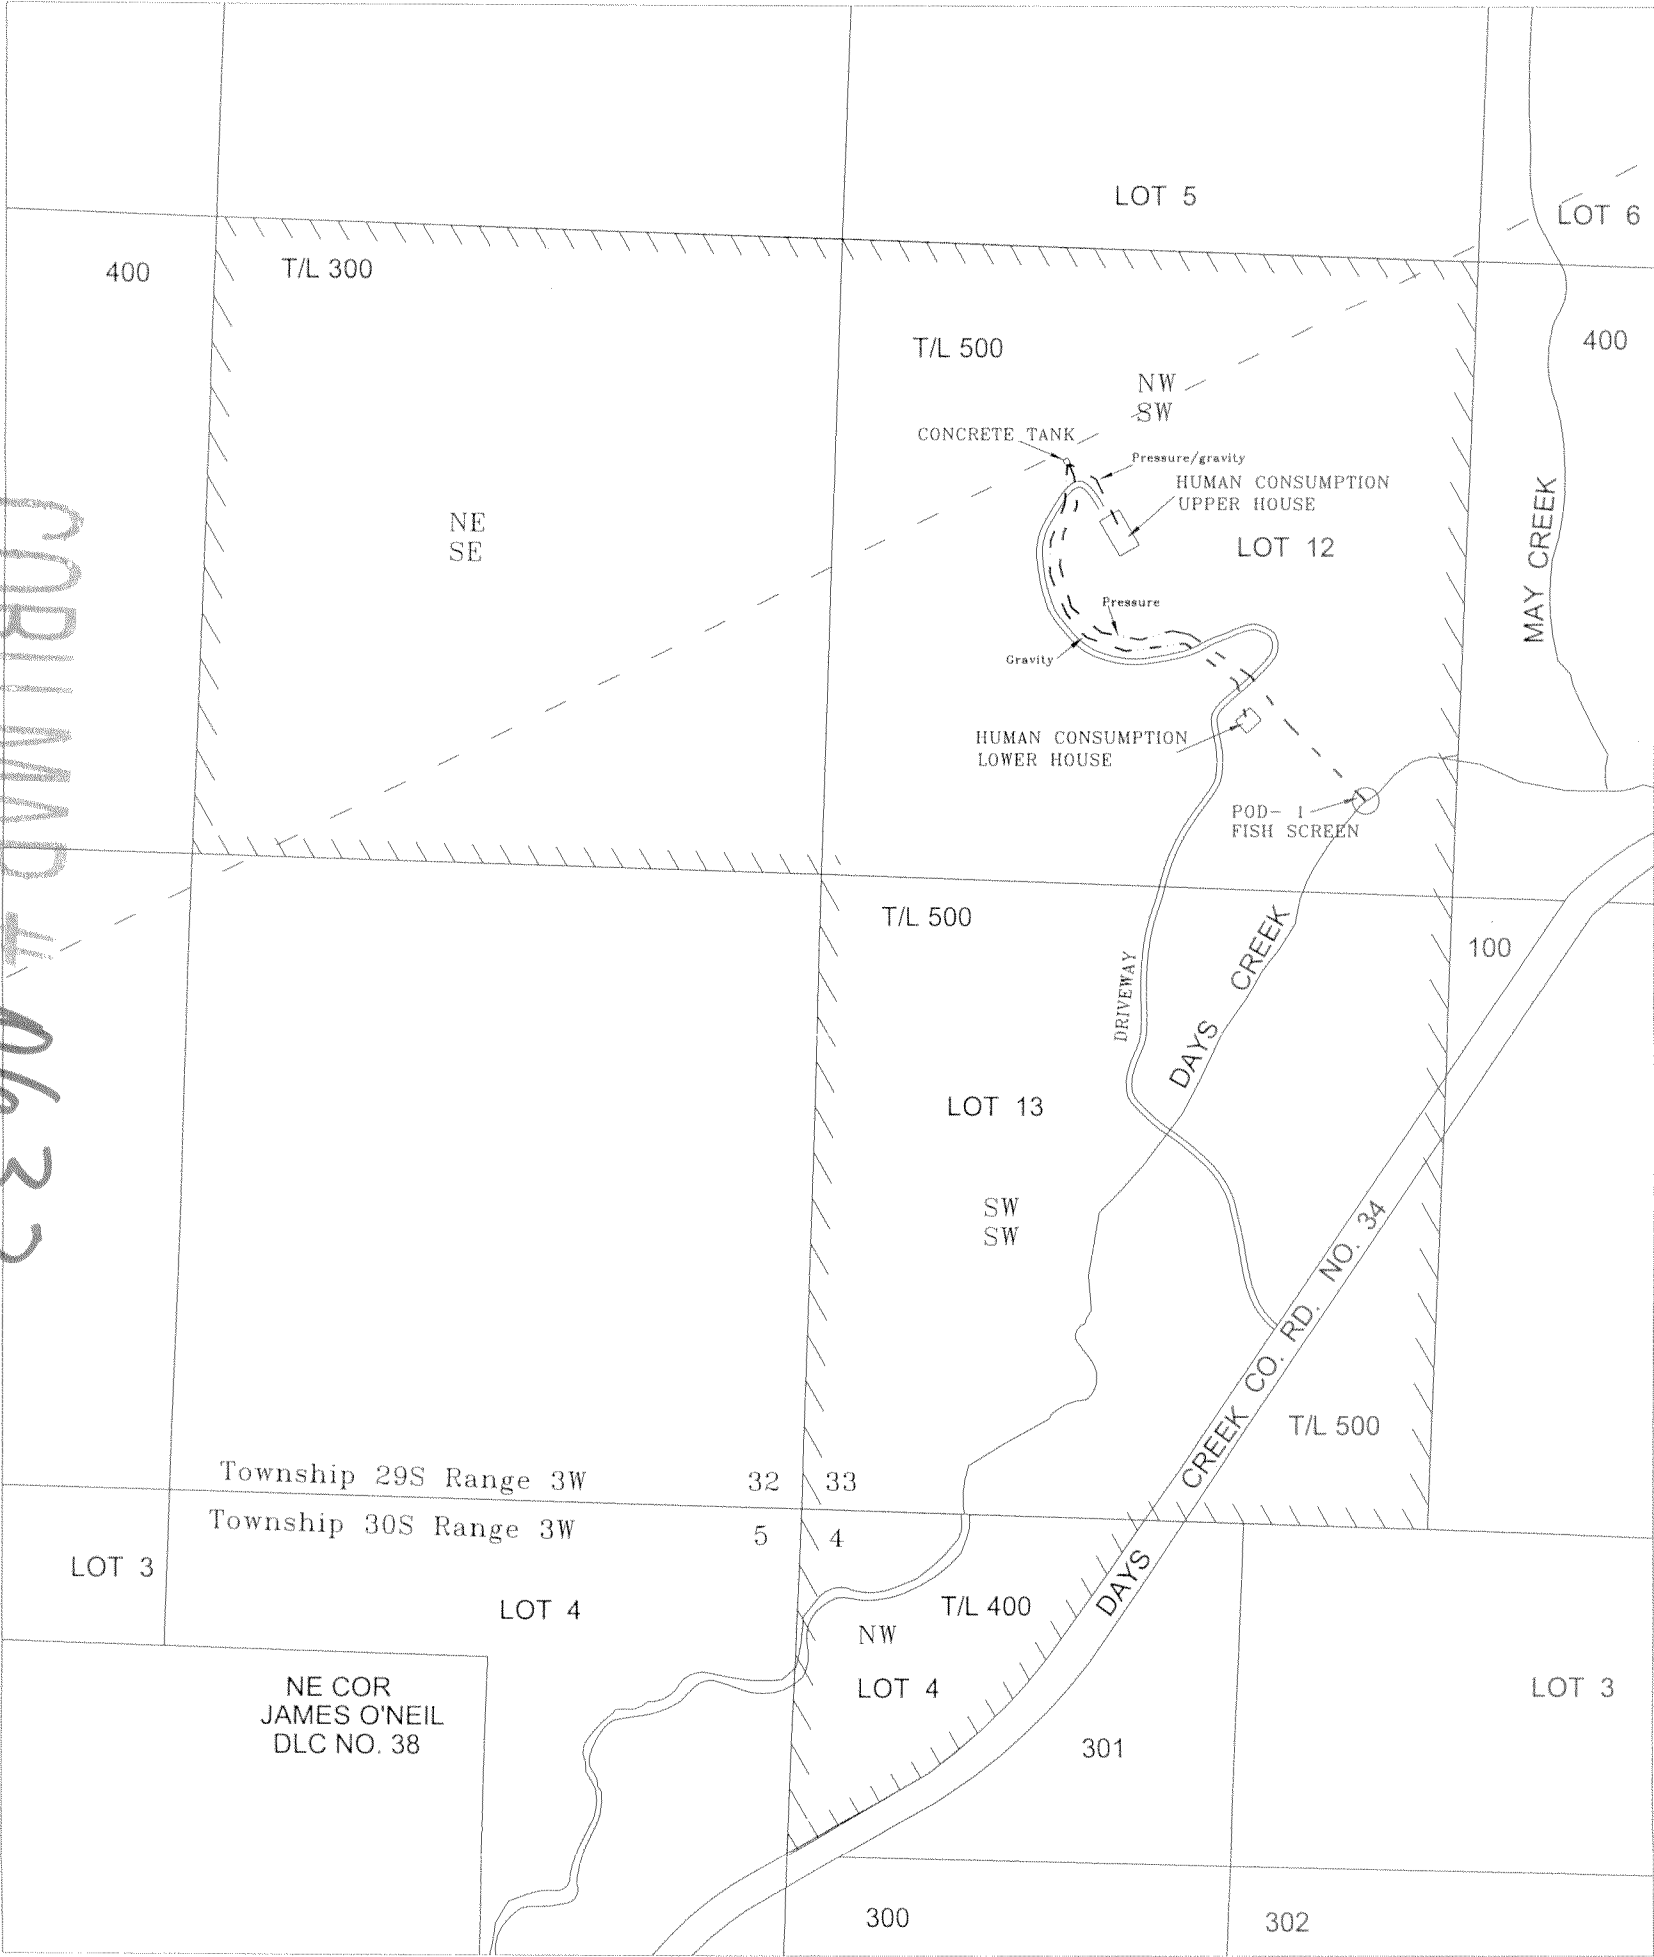

IRRIGATION BOUNDARY UP TO 0.5 ACRES EACH.

POD-1 & Fish Screen: Per meandering creek more or less 1480 feet North and 1180 feet East from the SW corner of Section 33, common with 32, 5 & 4.

----- 1" black poly/PVC buried of un-know location.

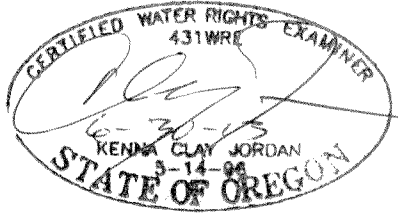

RECEIVED

NOV 11 2013

WATER RESOURCES DEPT
SALEM, OREGON



1" = 400'

This map is not intended to provide legal dimensions and/or locations of property ownership lines.

Locations per 1/4 1/4 are derived by assumed fit of aerial photo orientation to ground surveys and/or tax assessor maps.

JORDAN ENGINEERING
460 JORDAN LANE
ROSEBURG, OREGON 97471
(541) 673-1931

09-16-11