


This map was prepared by  
 DISTRICT 8 WATERMASTER  
 RICK LUSK, UNDER THE DIRECTION  
 AND CONTROL OF C.W.R.E.

MAP. 1 OF 2

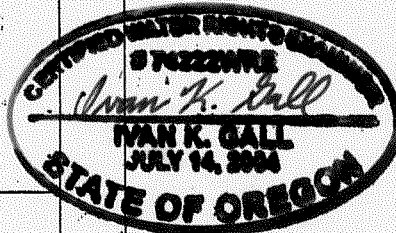

- 73599
- 73572
- 73593
- 73610
- 73405
- 73580
- 4387
- 4070
- 73999
- 73583
- 73406
- 73410
- 73567
- 73552
- 73594

RECEIVED

JAN 28 2010

WATER RESOURCES DEP  
 SALEM, OREGON

T. 8. S. R. 40. E. W.M.


T. 9. S. R. 40. E. W.M.

SCALE: 1" = 1320'

THIS MAP IS NOT INTENDED TO  
 PROVIDE LEGAL DIMENSIONS  
 OR LOCATIONS OF PROPERTY  
 OWNERSHIP LINES.

(18) P.O.D. 110' S. 600' W. FROM N.E. COR. SEC. 8,  
 T. 9. S. R. 40. E. W.M., ADDITIONAL, ESTES WEST  
 PIPELINE.

ESTES EAST.  
 (18) P.O.D. T. 9. S. R. 40. E. W.M. SEC. 8,  
 100'S. - 550' W. FROM N.E. COR. SEC. 8

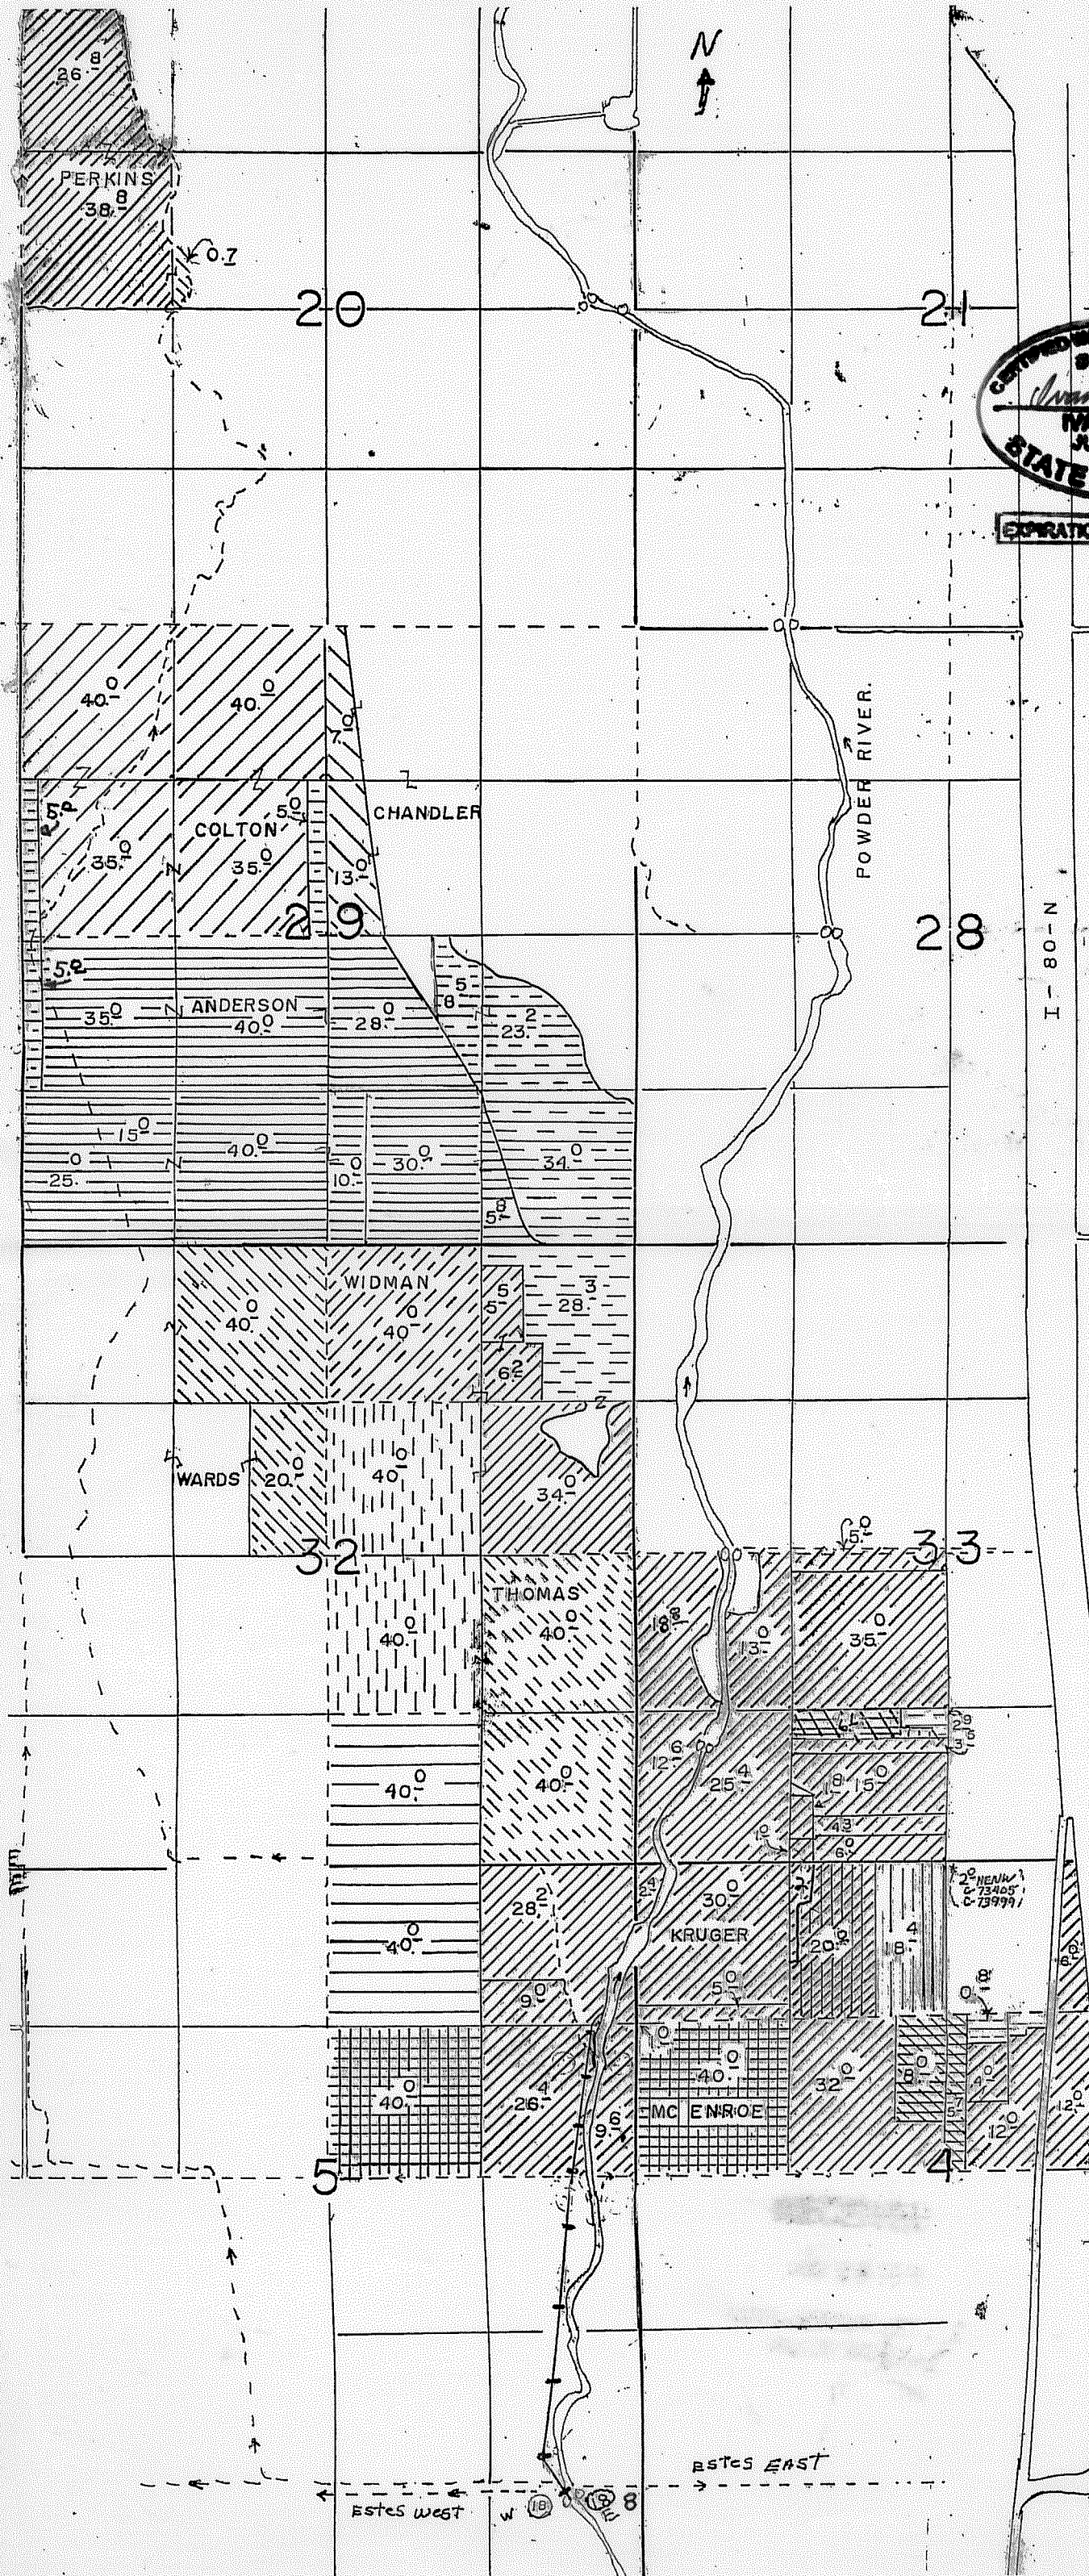

I - 80 - N

ESTES EAST

ESTES WEST

J.C.



