


28 27  
33 34

T28S R7W WM

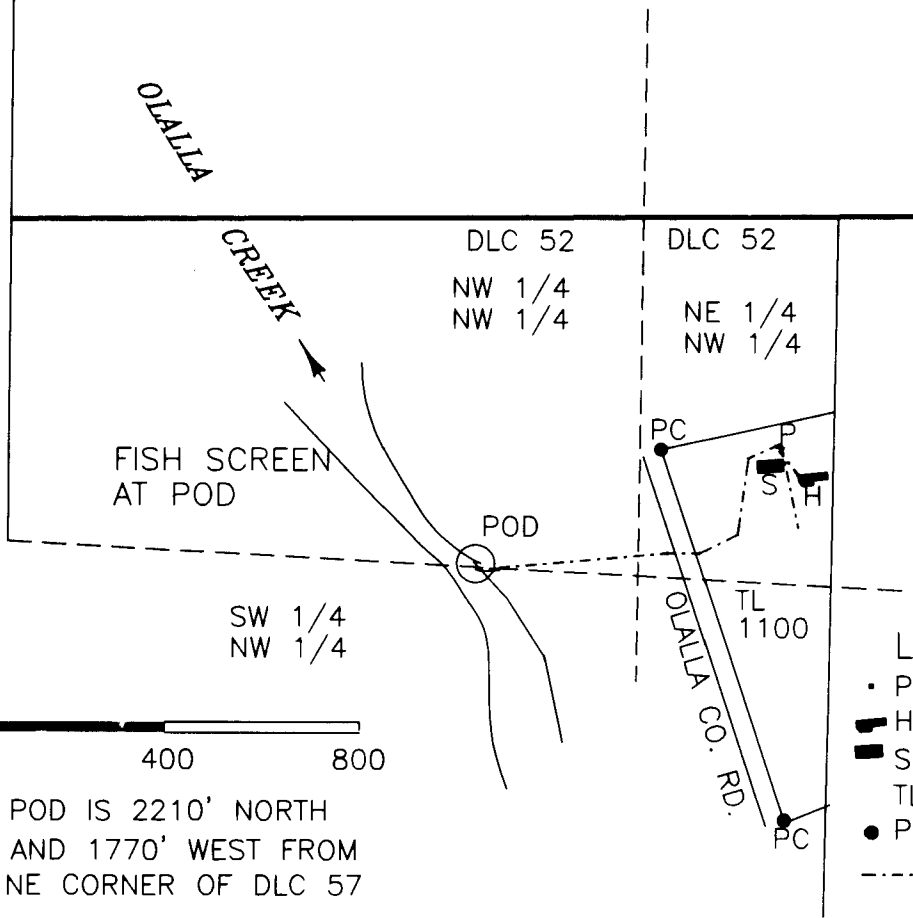

LEGEND

- P PUMP HOUSE
- H HOUSE
- S SHOP
- TL TAX LOT
- PC PROPERTY COR.
- BURIED 1.5" PVC PIPE

# MAP FOR CLAIM OF BENEFICIAL USE


## GREG RIETMANN

APPLICATION S-71359, PERMIT 52149

STORED WATER IS RELEASED FROM BEN IRVING RESERVOIR CONSTRUCTED UNDER PERMIT R-8444

DATE APRIL 13, 2011

BY: WILLIAM J. RUPPERT  
P.O. BOX 1564  
MYRTLE CREEK, OR 97457

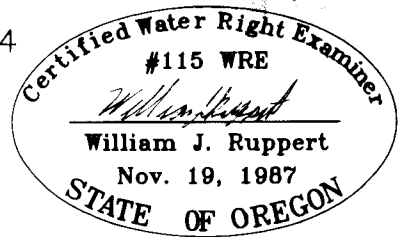

EXPIRES DEC. 31 2012

This map not to be used to determine legal dimensions or property lines.