


Tax Lot No. TL400 23 12 9CA

Section 9 Township 23 South, Range 12 West, W.M.
Coos County

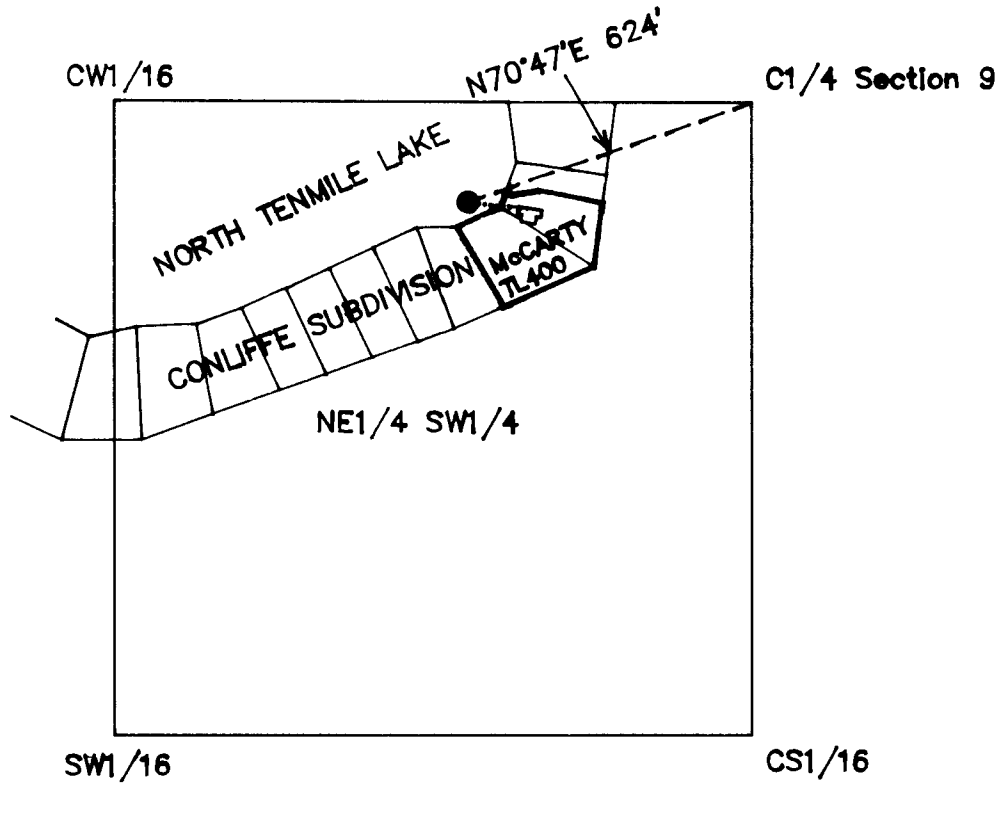

LEGEND

-  HOME
-  POINT OF DIVERSION & FISH SCREEN
-  WATERLINE
-  PROPERTY LINE

NO FISH BYPASS: THE POD IS A SUBMERSIBLE PUMP HANGING
FROM A DOCK AND DOES NOT IMPEDE FISH PASSAGE.
NO WATER METER REQUIRED
NO WATER MEASURING DEVICE REQUIRED

EXAMINERS DISCLAIMER STATEMENT

The preparation of this map was for the purpose of
identifying the location of the Water Right only and
has no intent to provide dimensions or location of
property ownership lines.


FINAL PROOF SURVEY
IN THE NAME OF

J. Bruce McCarty and Dorothy Jean McCarty

Surveyed on 6/17/11 by H.A. Wilcox

RECEIVED

WATER RESOURCES DEPT
SALEM OREGON

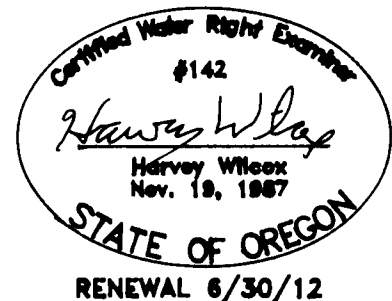

Application No. S-81033
Permit No. S-53092