

RECEIVED

SEP 30 2009


WATER RESOURCES DEPT
SALEM, OREGON

Claim of Beneficial Use



T-10183

Kathryn and Gary Yoder

28 27
33 34

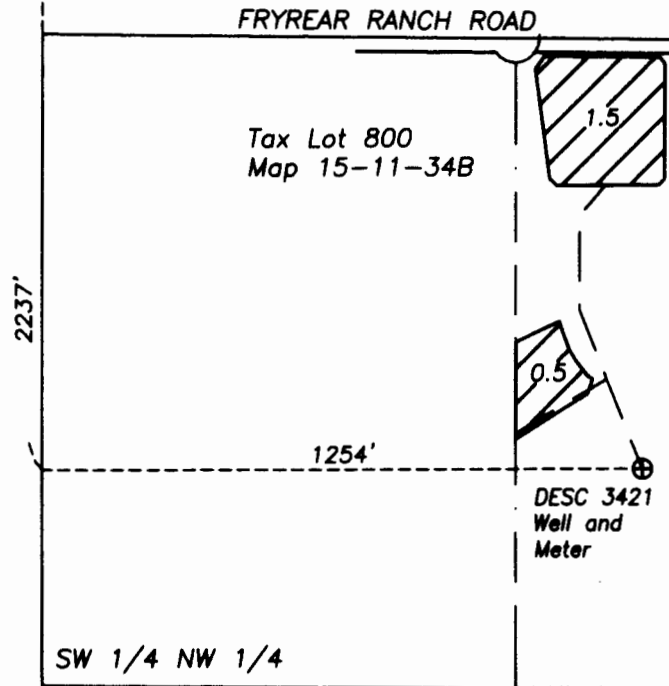

Section 34
T15S, R11E, W.M.
Deschutes Co., Oregon

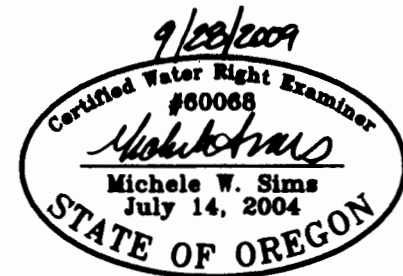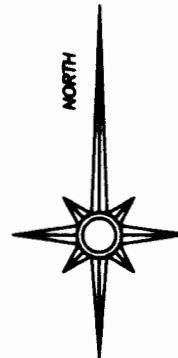

Renewal date: 6/30/2010

Legend



Water beneficially applied under transfer
T-10183, priority date 8/31/1992.

--- Property line

--- Mainline

400 0 400 800 1200



GRAPHIC SCALE - FEET

THIS MAP IS FOR THE PURPOSE OF IDENTIFYING THE LOCATION OF THE WATER RIGHT. IT IS NOT INTENDED TO PROVIDE LEGAL DIMENSIONS OR LOCATIONS OF PROPERTY OWNERSHIP LINES.