


T. 30 S., R. 3 W., W.M.

SCALE: 1" = 400'

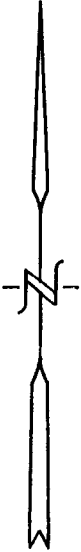

WEST 1/4 COR.
SEC. 24, T. 30 S., R. 3 W., W.M.
FD. 1" IRON PIPE

P.O.D.

P.O.D. IS 295 FEET NORTH AND 634 FEET
EAST OF THE WEST QUARTER CORNER OF
SECTION 24, T. 30 S., R. 3 W., W.M.

THIS MAP IS NOT INTENDED TO PROVIDE
LEGAL DIMENSIONS OR LOCATIONS OF
PROPERTY OWNERSHIP LINES.

T.L. 300

S.W. 1/16 COR.
FD. 5/8" IRON ROD

PART OF T.L. 400
GLOCKNER
RESERVOIR

PLACE OF USE
WATERING ROADS WITHIN
DOUGLAS COUNTY.



EXP. 12/31/2013

FINAL PROOF SURVEY

UNDER

TRANSFER APPLICATION

R 85709

T-9505

RECEIVED BY OWRD

IN NAME OF

GLOCKNER INVESTMENT

DEC 23 2015

Surveyed DEC. 21, 2011

by: R.F. BROWN

SALEM, OR