



THIS MAP WAS PREPARED FOR
ASSESSMENT PURPOSE ONLY.

SEC.26 T.25S. R.6W. W.M.
DOUGLAS COUNTY
1" = 400'

REVISED ON
2-25-08

25 6 26

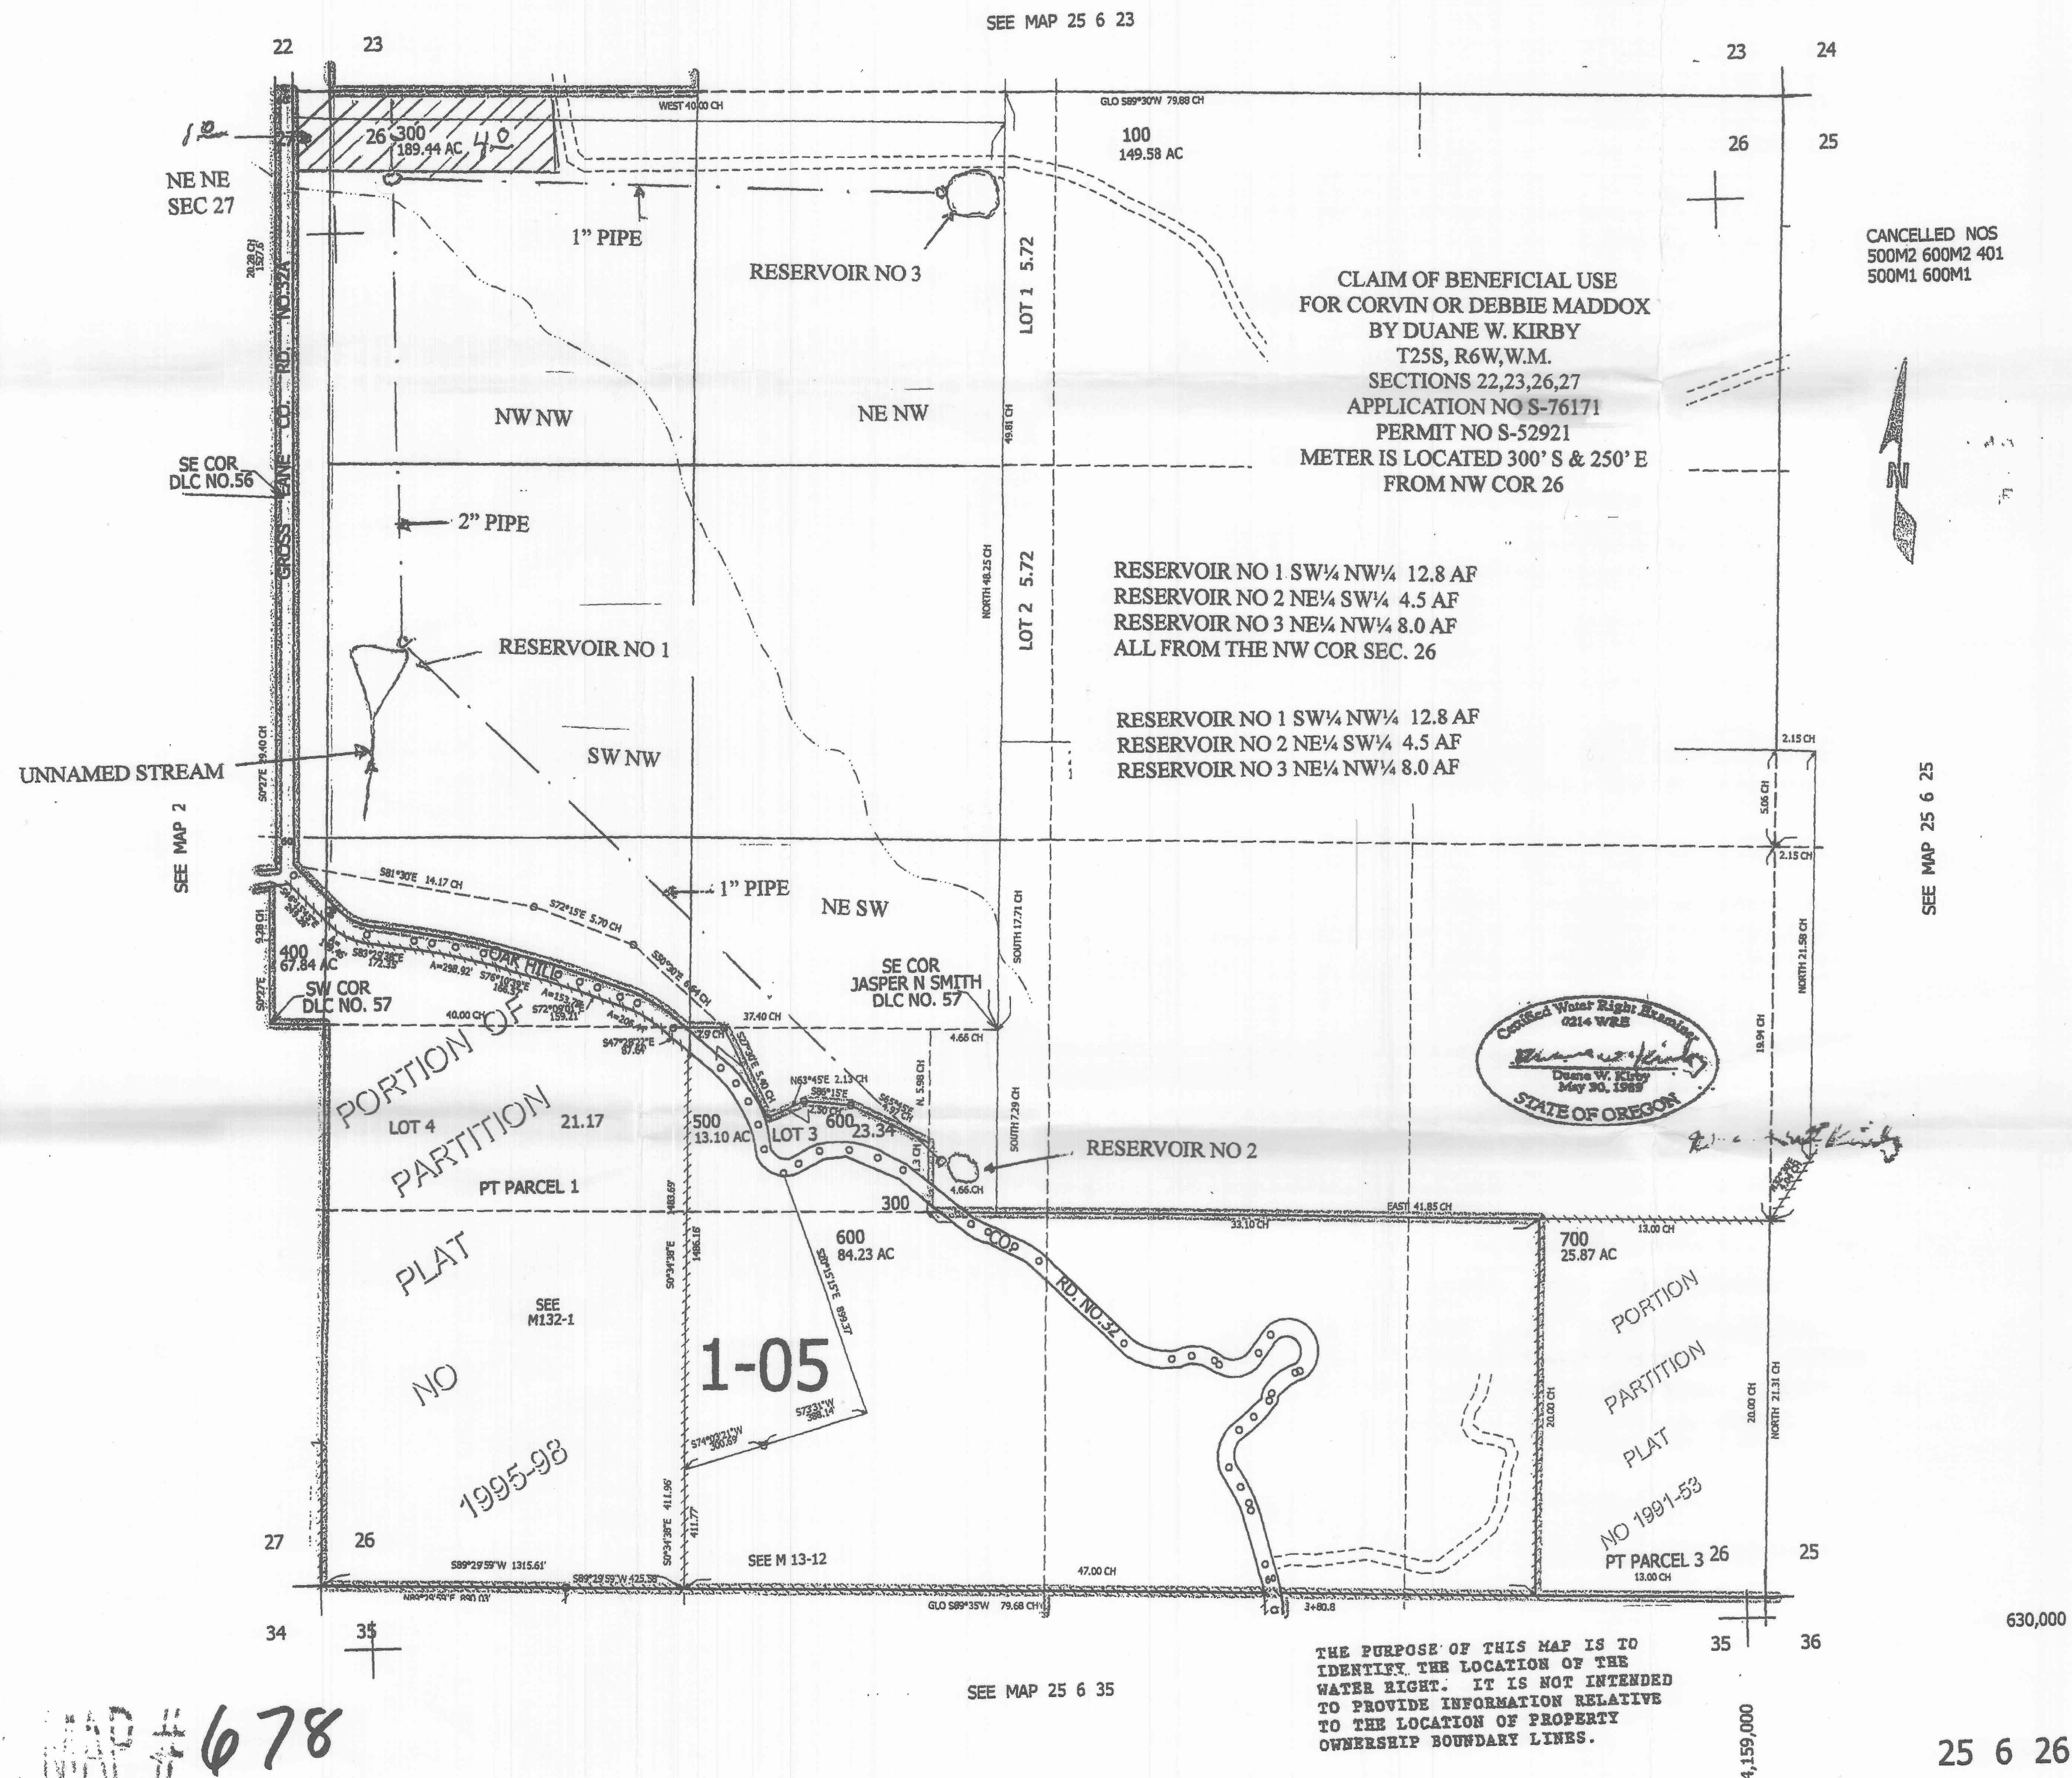

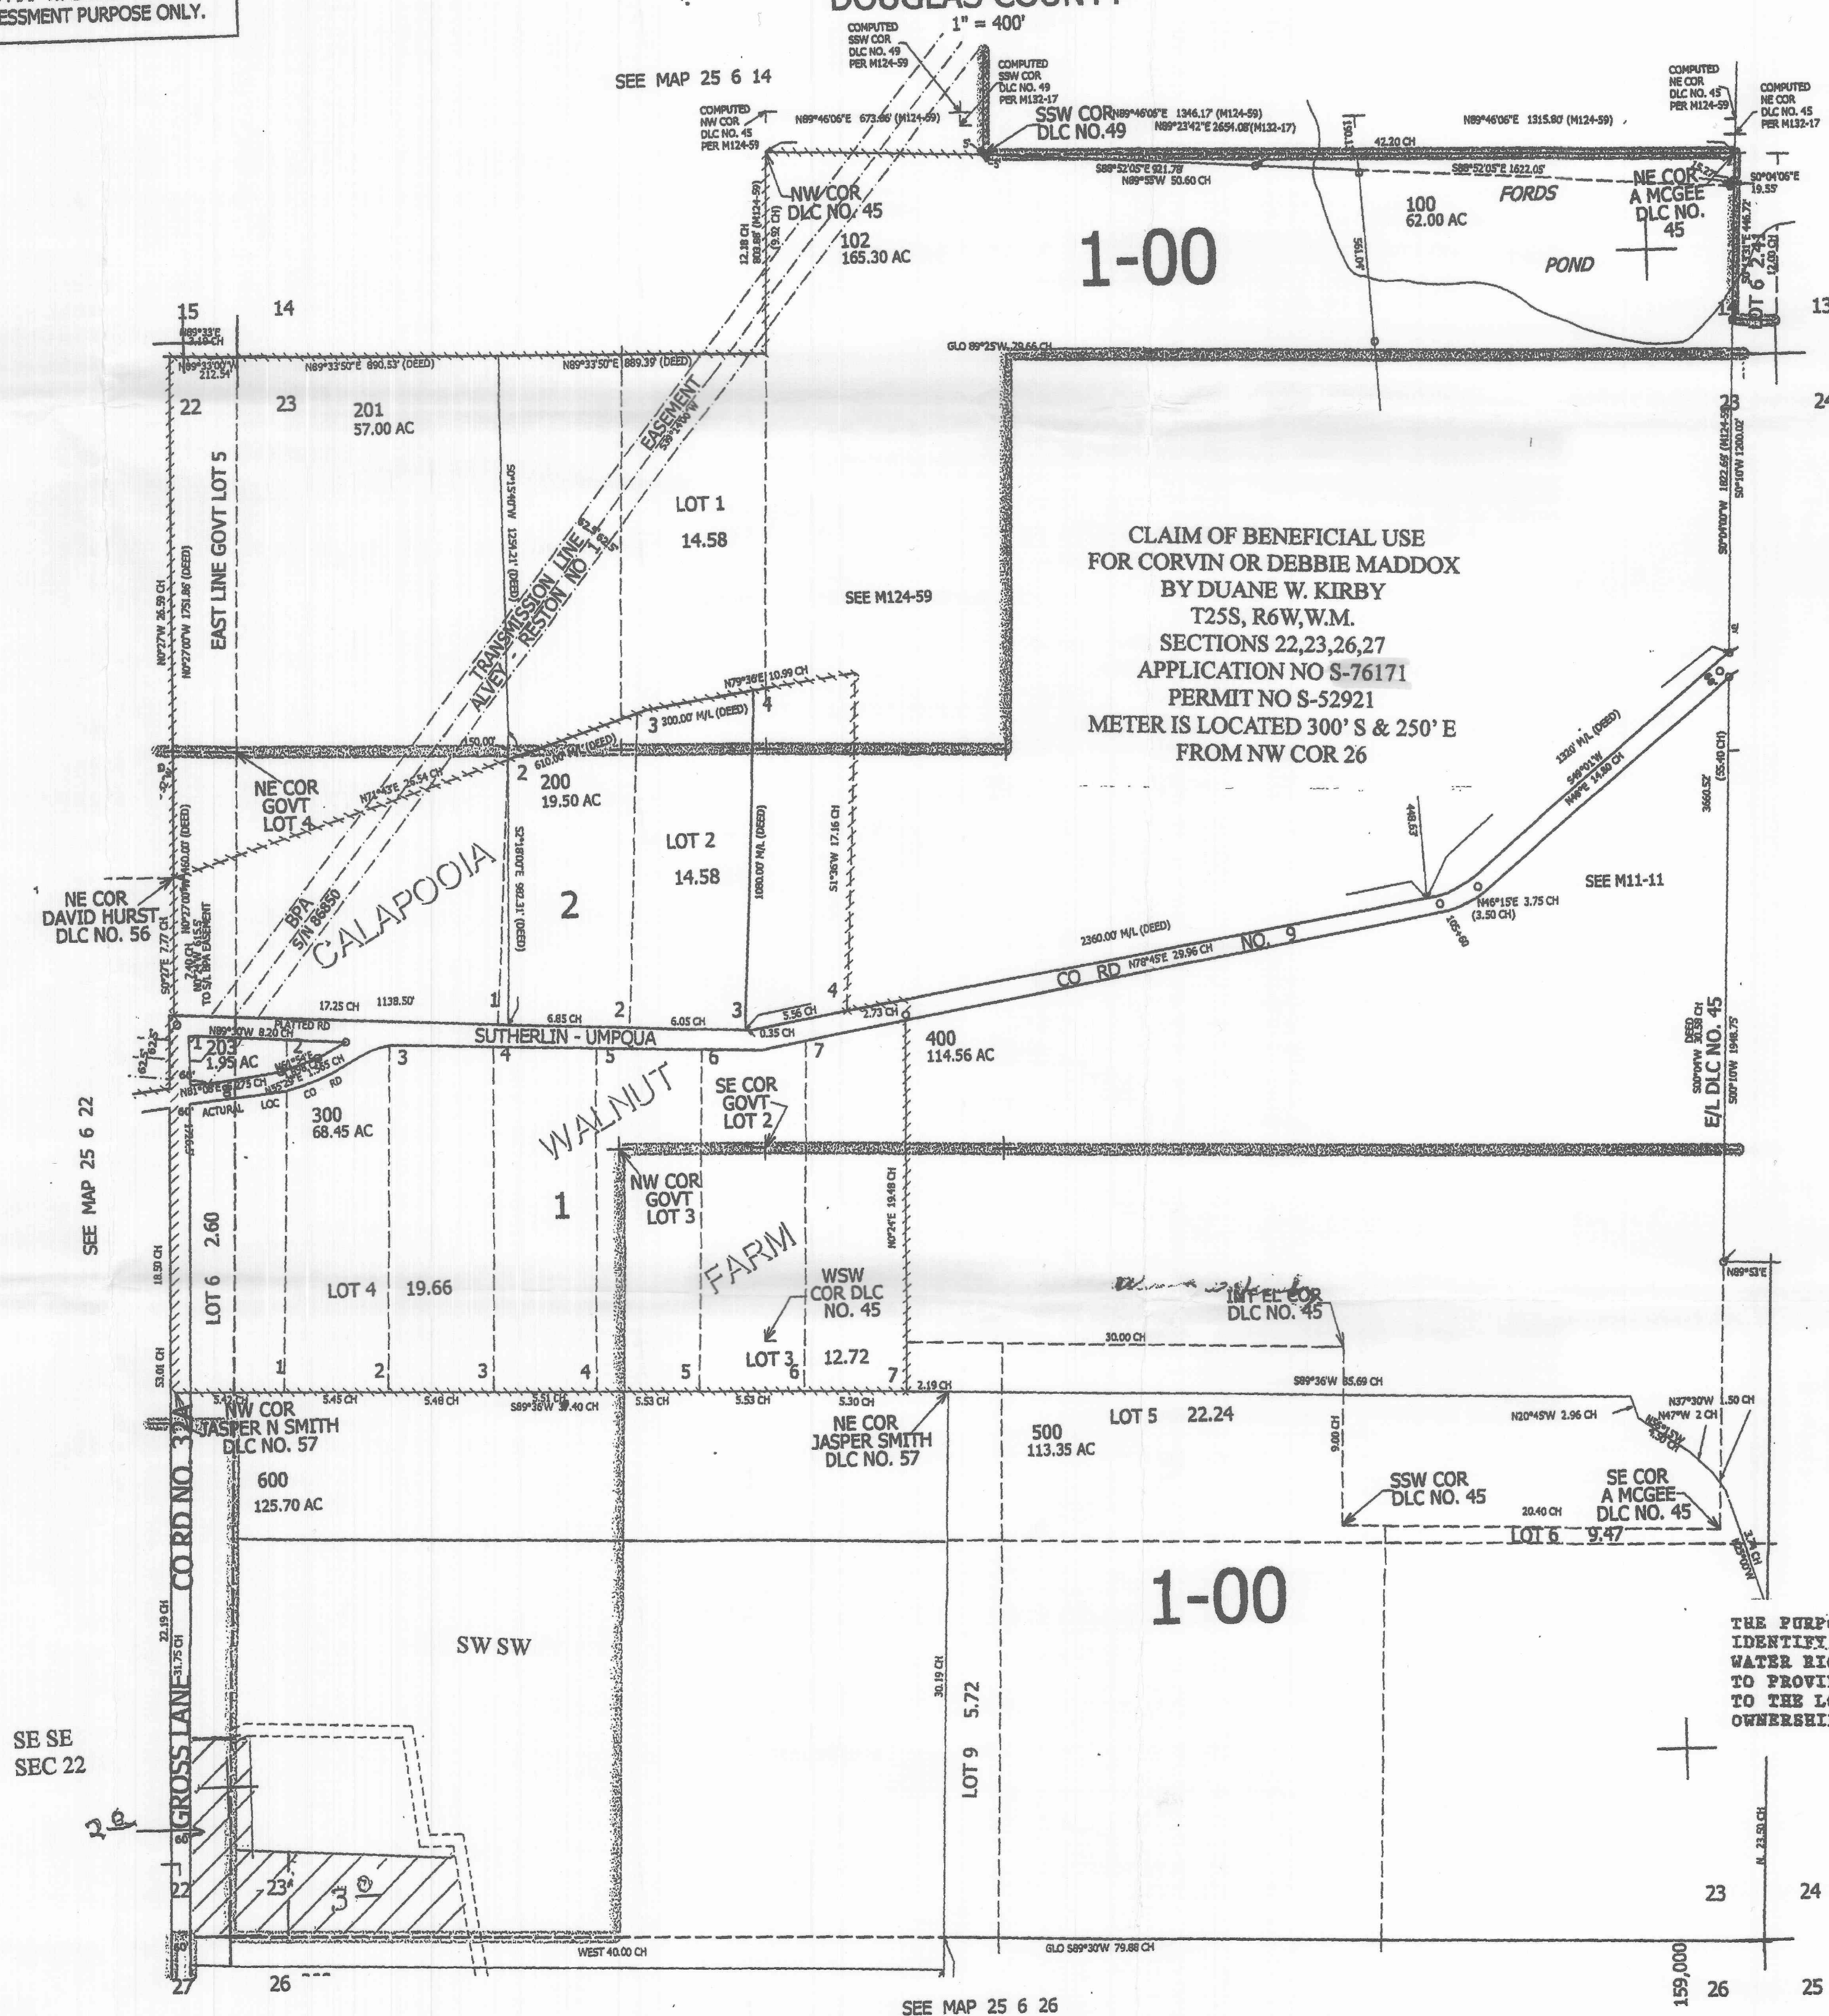

CANCELLED NOS
101 202 103


FOOTNOTES

MAR 19 2012




SEE MAP 25 6 24

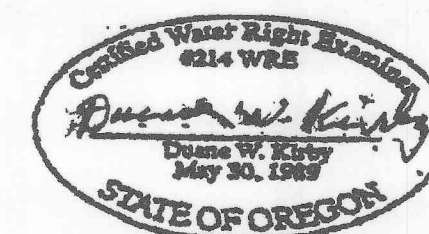

THE PURPOSE OF THIS MAP IS TO IDENTIFY THE LOCATION OF THE WATER RIGHT. IT IS NOT INTENDED TO PROVIDE INFORMATION RELATIVE TO THE LOCATION OF PROPERTY OWNERSHIP BOUNDARY LINES.

678
2 of 2