


# T15S, R16E, SECTIONS 30 & 31, WM

CROOK COUNTY, OREGON

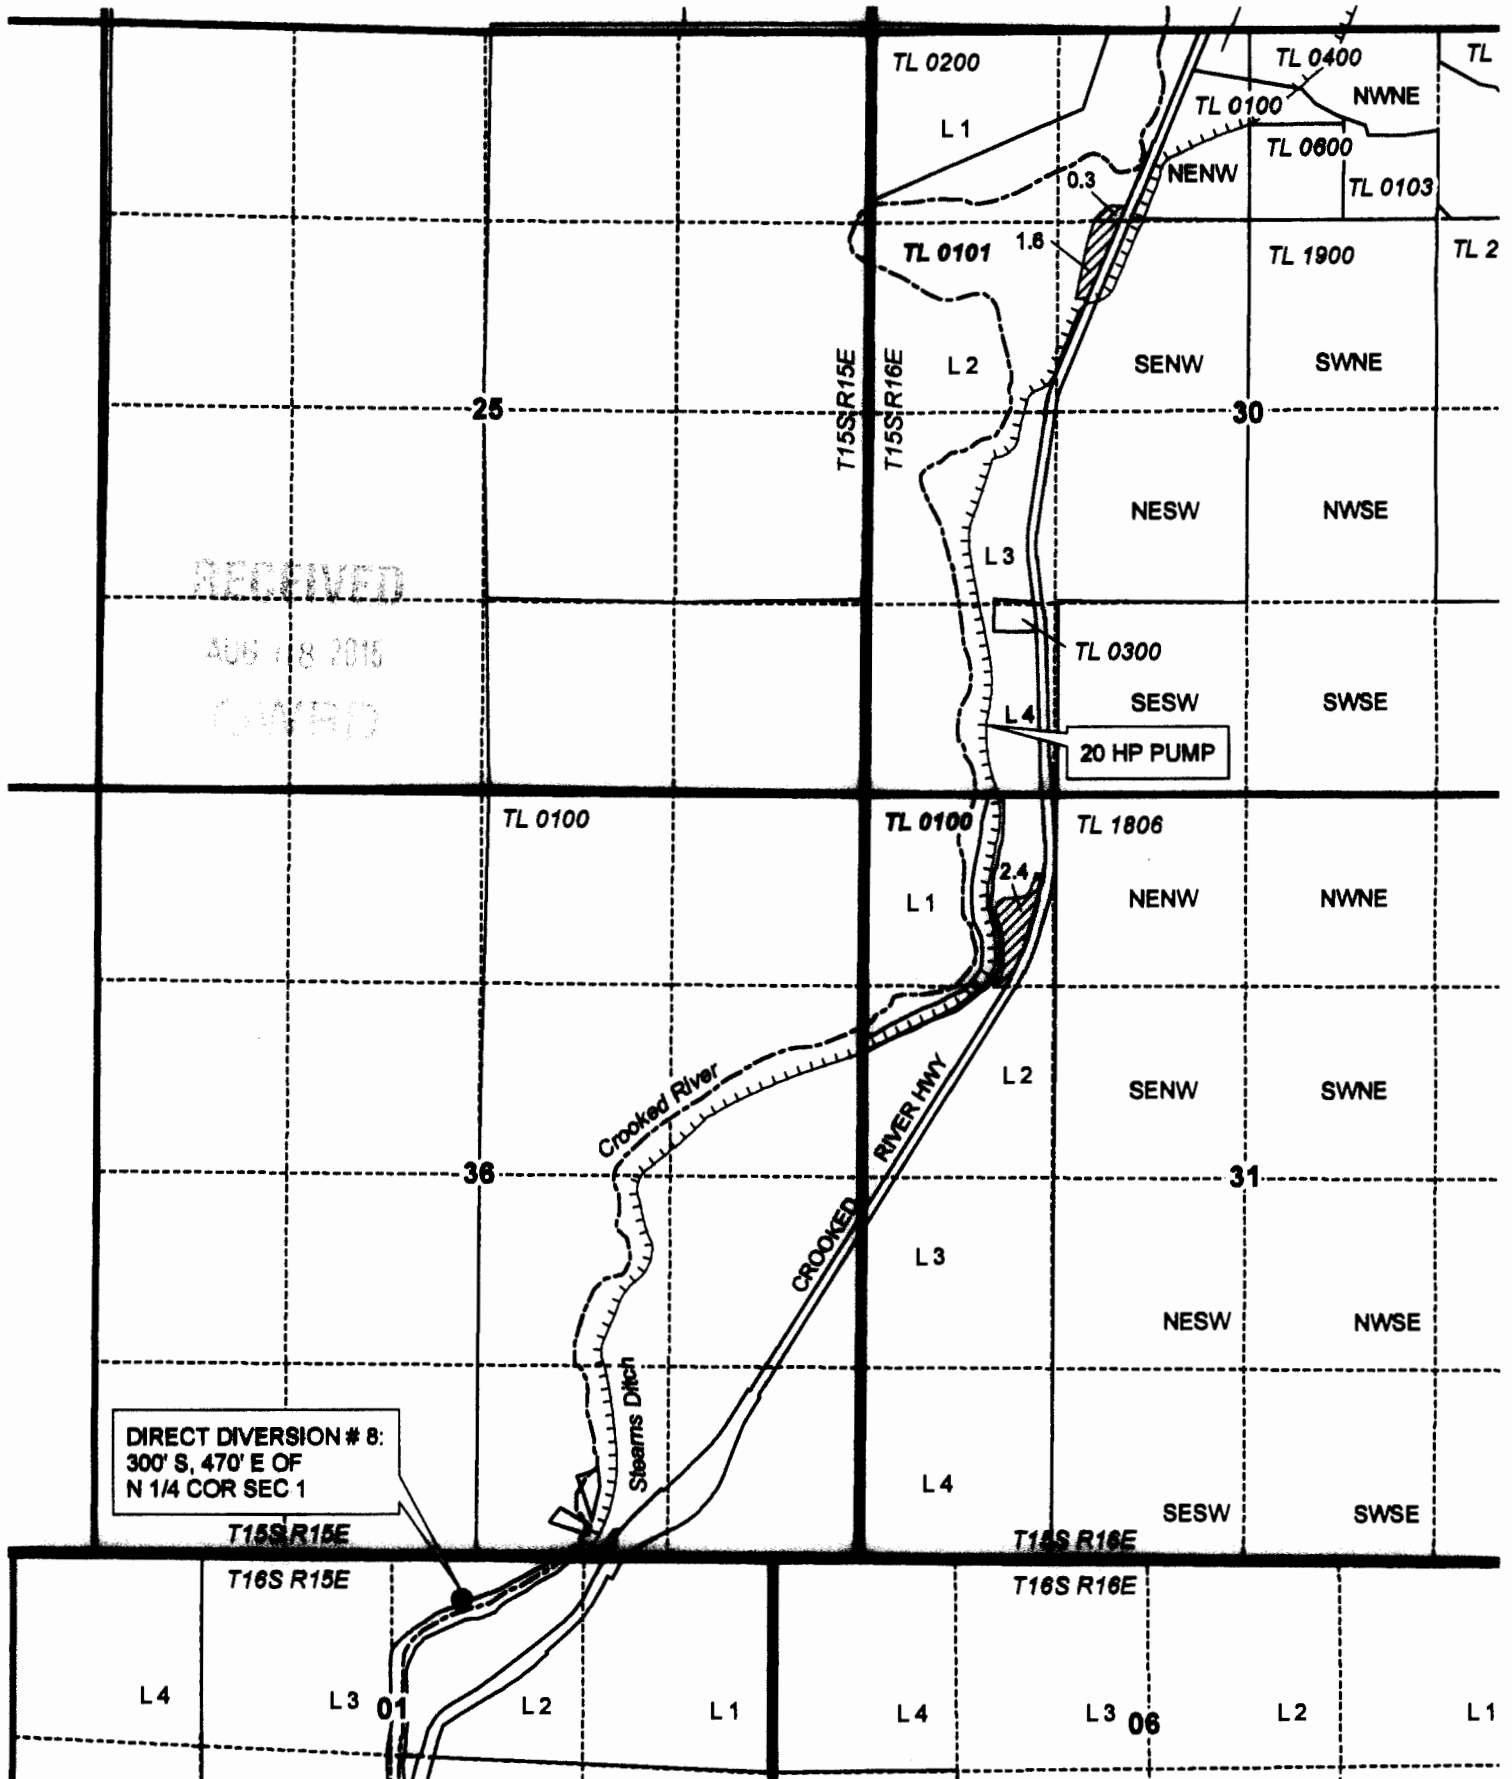

RECEIVED  
AUG 18 2016  
CWRD

DIRECT DIVERSION # 8:  
300' S, 470' E OF  
N 1/4 COR SEC 1

- POU IS from Cert 83443
- Township
- Section
- Quarter Quarter
- Tax Lot
- River
- Canal
- Point of Diversion



NOTE: THIS MAP IS NOT INTENDED TO PROVIDE LEGAL DIMENSIONS OR LOCATIONS OF PROPERTY OWNERSHIP LINES.

AUGUST 5, 2016

RENEWAL DATE 12/31/2016

**CLAIM OF BENEFICIAL USE**  
Quail Valley Ranch

**WATER RIGHT SERVICES, LLC**

PO BOX 1830, BEND, OR 97709

CCB# 197121 [www.oregonwater.us](http://www.oregonwater.us)

541-389-2837 [JOHNSHORT@USA.COM](mailto:JOHNSHORT@USA.COM)

PRIORITY 04/08/1914

TRANSFER T-9172