



T.18S. R.8E. Section 32, W.M.

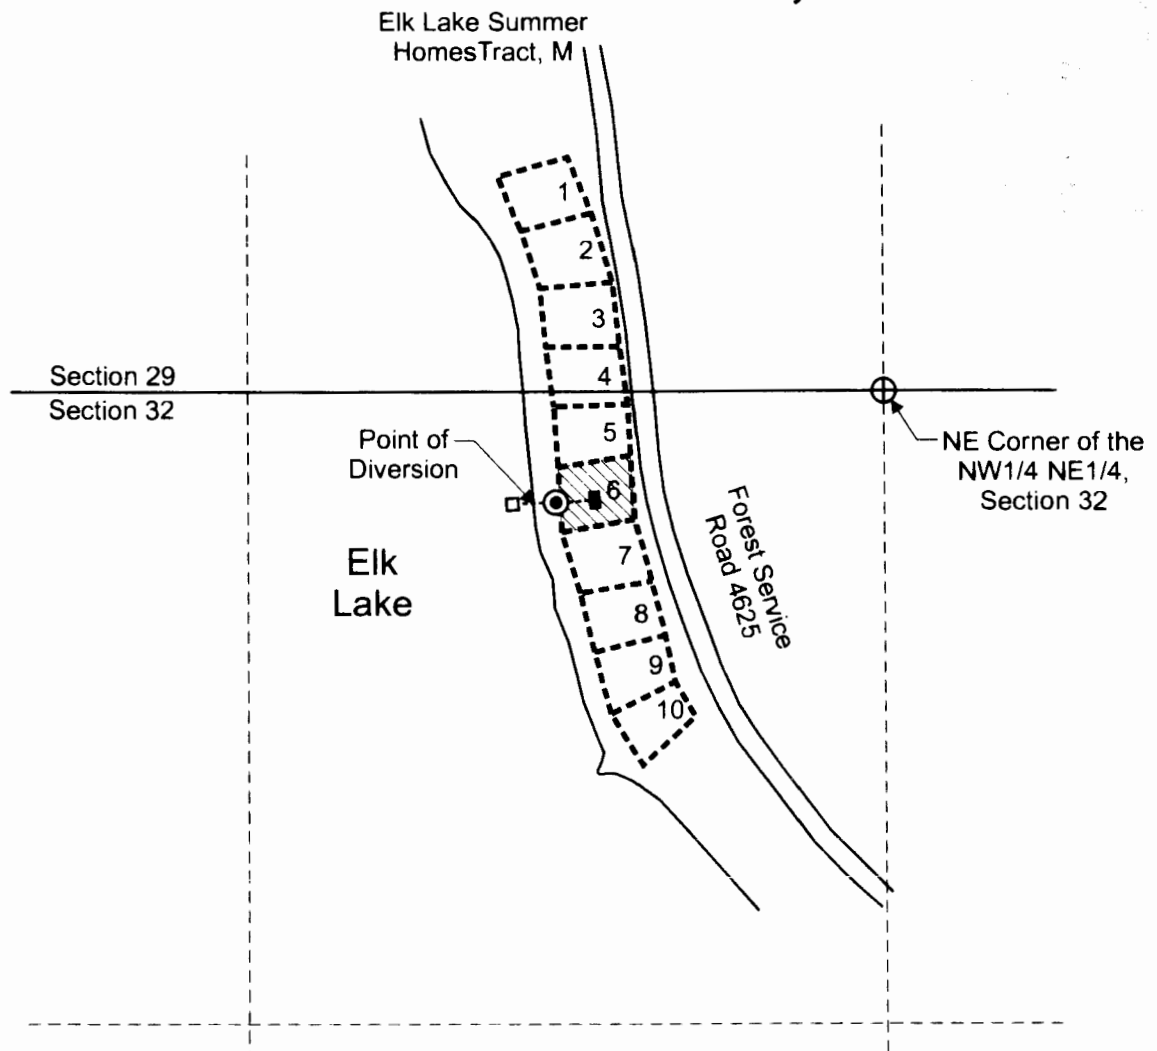

Point of Diversion is located 230 feet south and 730 feet west from NE corner of the NW1/4 NE1/4, Section 32.
Note: Location of pump and meter is subject to change depending on lake level.

-  Location of use for Human Consumption.
-  Tax lot boundary
-  Pump location
-  Meter location
-  Fish screen location
-  Mainline

Scale: 1" = 400'

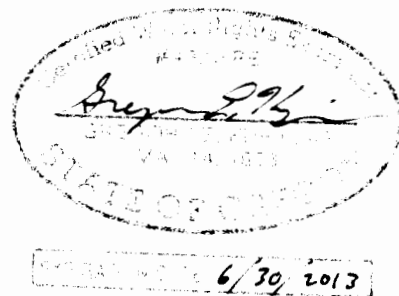

This map was prepared for the purpose of identifying the location of a water right only and is not intended to provide legal dimensions or location of property ownership lines.

Claim of Beneficial Use Map
Application S-86905, Permit S-54621

Elk Lake Tract M - Kathleen Hoffman
T.18S. R.8E. Section 32, W.M.

Pacific Hydro-Geology Inc.

11/2011