


CLAIM OF BENEFICIAL USE
FOR: ANGELA M. HUNT
BY: DUANE W. KIRBY
T30, R2W, W.M.
NE 1/4 NW 1/4 AND NW 1/4 NW 1/4 OF SEC 33
TAX LOT 700
APPLICATION NO. S-80984
PERMIT MO. S-53230
FISH-SCREEN LOCATED AT THE POD
SCALE: 1" = 400'

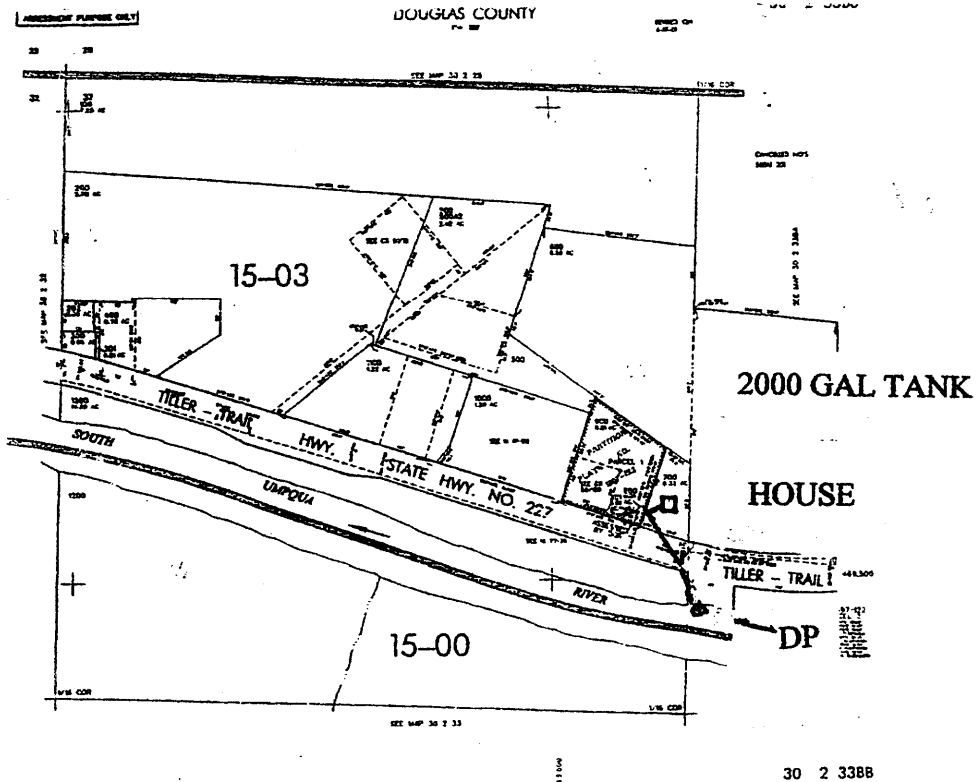

POINT OF DIVERSION LOCATION: NE 1/4 NW 1/4, SECTION 33, TOWNSHIP 30 SOUTH, RANGE 2 WEST, W.M.; NORTH 4 DEGREES EAST 250 FEET FROM THE NW 1/16 CORNER OF SECTION 33

THE PURPOSE OF THIS MAP IS TO IDENTIFY THE LOCATION OF THE WATER RIGHT. IT IS NOT INTENDED TO PROVIDE INFORMATION RELATIVE TO THE LOCATION OF PROPERTY OWNERSHIP BOUNDARY LINES.

