

CLAIM OF BENEFICIAL USE MAP

LOCATED IN THE SW $\frac{1}{4}$ NW $\frac{1}{4}$ OF SECTION 10,
TOWNSHIP 23 SOUTH, RANGE 12 WEST, W.M.

COOS COUNTY, OREGON

APPLICATION S-80973, PERMIT S-53090


PREPARED FOR; JAMES O. SUMMERS

PREPARED BY: DENNIS GOUDE

DATE: DECEMBER 30, 2011

NOTE:

THE POINT OF DIVERSION IS
LOCATED 72 FEET NORTH OF
THE SOUTHEAST CORNER OF
TAX LOT 1500. THE P.O.D.
IS A $\frac{1}{2}$ HP SUBMERSIBLE
PUMP

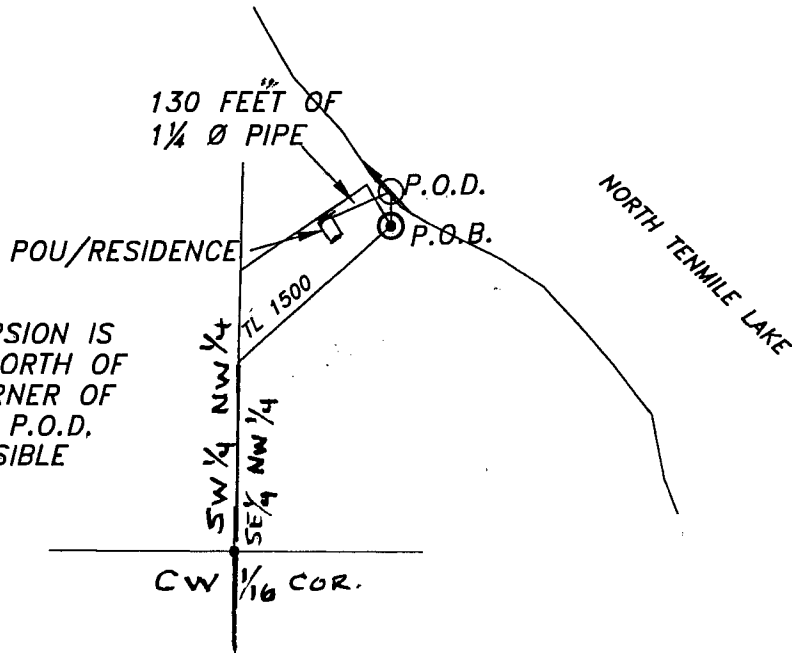

LEGEND

POINT OF BEGINING



POINT OF DIVERSION



POU/RESIDENCE



RECEIVED

JAN 13 2012

WATER RESOURCES DEPT
SALEM OREGON



EXPIRES 6/30/2012

SCALE 1" = 400 FT.



**Stuntzner Engineering
& Forestry, L.L.C.**

ENGINEERING • LAND SURVEYING • FORESTRY
PLANNING • WATER RIGHTS

705 South 4th St.
Post Office Box 118
Coos Bay, Oregon 97420
Phone: (541) 267-2872
Fax: (541) 267-0688

EXAMINERS DISCLAIMER STATEMENT

THE PREPARATION OF THIS MAP WAS FOR THE PURPOSE
OF IDENTIFYING THE LOCATION OF THE WATER RIGHT ONLY
AND HAS NO INTENT TO PROVIDE DIMENSIONS OR LOCATION
OF PROPERTY OWNERSHIP LINES.