

APPROXIMATE UN-SURVEYED TOWNSHIP

T23S., R6E., W.M.

SECTION 14


CLAIM OF BENEFICIAL USE

APPLICATION S-87183, PERMIT S-54631

TAX LOT 100G5, MAP 2306

KLAMATH COUNTY, OREGON


JUNE 22, 2011

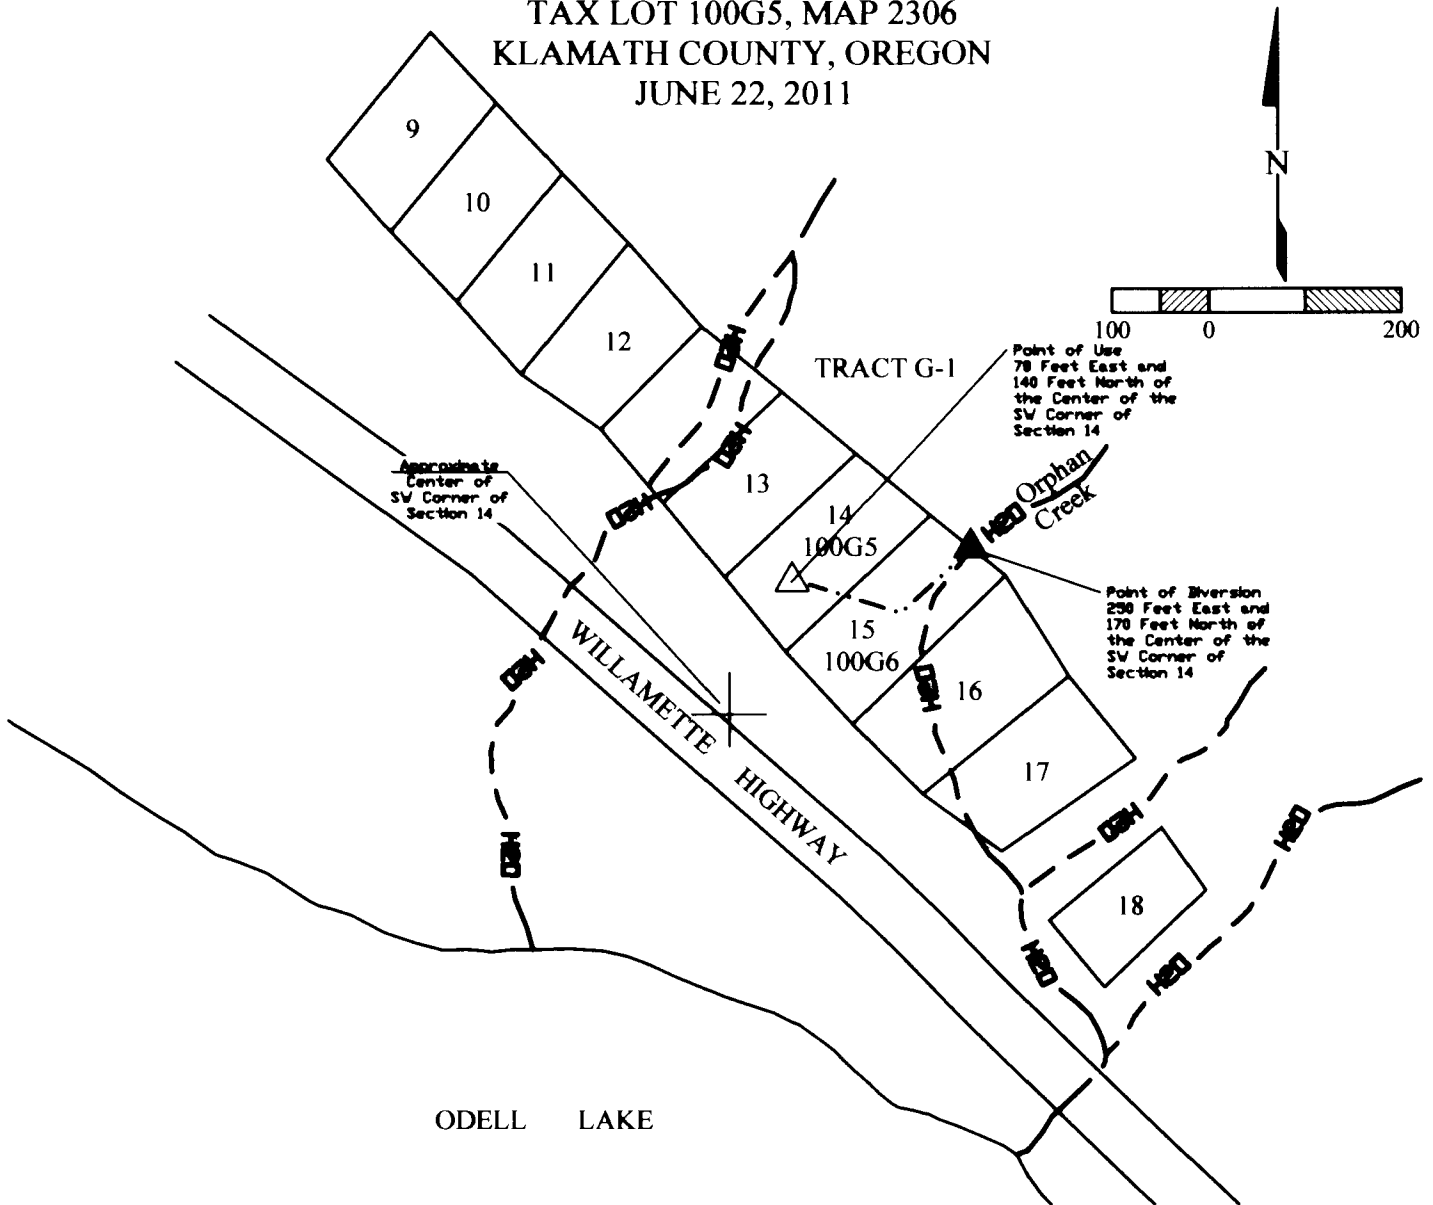

BASE MAPPING BY KLAMATH COUNTY TAX MAP 23-06. THIS MAP HAS BEEN PREPARED FOR THE SOLE PURPOSE OF IDENTIFYING THE REQUESTED WATER RIGHT LOCATION. THERE IS NO INTENT TO PROVIDE DIMENSIONS OR LOCATIONS OF PROPERTY OWNERSHIP LINES.

LEGEND:

- APPROXIMATE LOCATION OF LEASE LOT LINES
- - - APPROXIMATE LOCATION OF DELIVERY PIPE
- ▲ APPROXIMATE LOCATION OF POINT OF DIVERSION AND FISH SCREEN
- △ PLACE OF USE AND METER LOCATION (METER UNDER HOUSE)

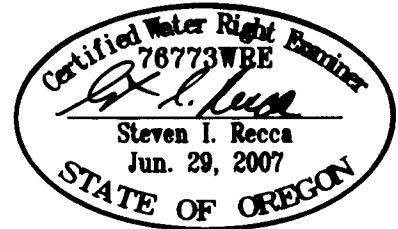

EXPIRATION DATE: 12/31/12



EGR & Associates, Inc.

Engineers, Geologists, and Surveyors

2535B Prairie Road
Eugene, Oregon 97402

(541) 688-8322
Fax (541) 688-8087